

TIPPAH
F 38
1-23-73

MISSISSIPPI
BOARD OF WATER COMMISSIONERS
416 North State Street
Jackson, Mississippi 39201

CODED

WATER WELL DRILLERS LOG

1-23-73 19 Jumpers Well Drilling Issaquah
date well completed firm name county well located

LANDOWNER:	description of formations encountered	from	to
<u>Donny Wilt</u> <u>Ripley Miss</u> (mailing address)			
WELL LOCATION: sec. <u>29</u> T <u>3</u> N R <u>4</u> E <u>4</u> miles <u>NE</u> of <u>Ripley</u> (distance) (direction) (nearest town)	<u>Rock & Sand</u>	<u>150</u>	<u>220</u>
WELL PURPOSE: <u>Home</u> (home, irrigation, municipal, industrial)			
WELL COMPLETION DATA:			
(1) diameter (inches) <u>4"</u>			
(2) total depth (feet) <u>220</u>			
(3) static water level (feet) <u>150</u> below top of ground.			
(4) casing <u>PVC</u> , <u>200</u> (material) (depth) <u>4</u> (size) if telescope see back.			
(5) screen <u>20</u> <u>200</u> (length) (depth to top) <u>1/32</u> <u>PVC</u> (size) (material)			
(6) pump <u>1/2</u> <u>8</u> (HP) (yield gpm) <u>Elec</u> (type power)			
(7) electric log <u>0</u> (yes or no) <u>0</u> (organization running log)			
(8) how well bottom plugged _____			
DRILLERS REMARKS:			

CODED

If well telescopes please sketch and show depths.

GROUND LEVEL


Clay

150

Rock

↓
Sand

220

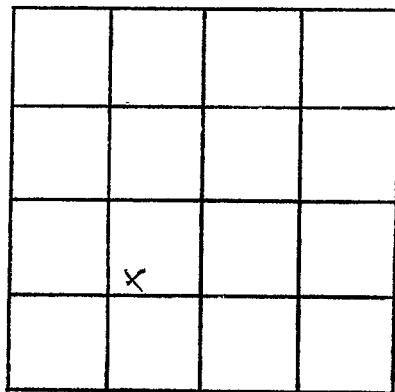

SECTION 29

Please indicate well location X.

ADDITIONAL INFORMATION

If more than one screen,
show locations of each on sketch.