

F 40
 Tippah
 5/7/75

MISSISSIPPI
 BOARD OF WATER COMMISSIONERS
 416 North State Street
 Jackson, Mississippi 39201

CODED

WATER WELL DRILLERS LOG

5 7 75 date well completed
 J T Madson firm name
 Tippah county well located

LANDOWNER: James Brock
Falkner Miss
 (mailing address)

description of formations encountered	from	to
Clay	0	11
Sand & Clay	11	35
Rock & Shell	35	90
Blue	90	130
Rock & Sand	130	189

WELL LOCATION:
 sec. 9 T. 2 N. R. 4 E.
4 miles E of Falkner
 (distance) (direction) (nearest town)

WELL PURPOSE:
 (home, irrigation, municipal, industrial)

WELL COMPLETION DATA:

(1) diameter (inches) 4

(2) total depth (feet) 189

(3) static water level (feet) 90 below above top of ground.

(4) casing P 100
 (material) (depth)

 If telescope see back.
 (size)

(5) screen
 (length) (depth to top)

 (size) (material)

(6) pump 1/2 8
 (HP) (yield gpm)

E
 (type power)

(7) electric log
 (yes or no)

 (organization running log)

(8) how well bottom plugged

CODED

DRILLER'S SIGNATURE


MAY 27 1975

DRILLERS REMARKS:

MISS. BD. OF WATER COMMISSIONERS

If well telescopes please sketch and show depths.

GROUND LEVEL

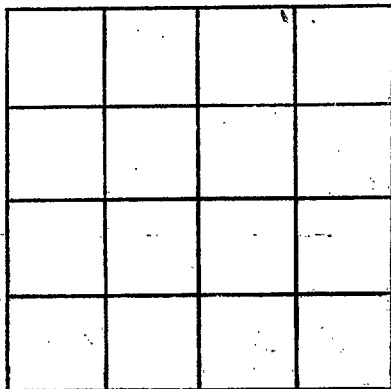

SECTION _____

Please indicate well location X.

ADDITIONAL INFORMATION

If more than one screen, show locations of each on sketch.