

MISSISSIPPI  
BOARD OF WATER COMMISSIONERS  
416 North State Street  
Jackson, Mississippi 39201

WATER WELL DRILLERS LOG

TIPPON  
E 2000  
1-10-76

16L


1-10-1976 date well completed  
J. I. Martin firm name  
Tippah county well located

LANDOWNER:	description of formations encountered	from	to
Wm. Eaton Ripley, MS. (mailing address)	Sand & silt	0-100	
WELL LOCATION: sec. 36 T. 3 N. R. 14 E. 8 miles of Ripley (distance) (direction) (nearest town)	Mud & clay	100-120	
WELL PURPOSE: (Home, irrigation, municipal, industrial)	Sand & silt	120-130	
WELL COMPLETION DATA: (1) diameter (inches) 4 inch (2) total depth (feet) 130 (3) static water level (feet) 145 Below above top of ground. (4) casing (material) (depth) 130 if telescope see back. (5) screen (length) (depth to top) 100 (size) (material) 4 in. Metal (6) pump (HP) (yield gpm) 2 1/2 (type power) Electric (7) electric log (yes or no) (organization running log) (8) how well bottom plugged			
DRILLERS REMARKS:			

RECEIVED  
FEB 2 - 1976

If well telescopes please sketch and show depths.

GROUND LEVEL

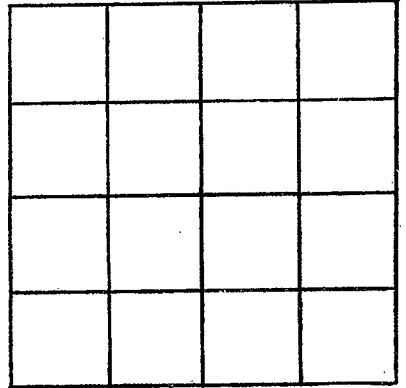

SECTION \_\_\_\_\_

Please indicate well location X.

ADDITIONAL INFORMATION

If more than one screen,  
show locations of each on sketch.