

MISSISSIPPI
BOARD OF WATER COMMISSIONERS
416 North State Street
Jackson, Mississippi 39201

WATER WELL DRILLERS LOG

TIPPAN
F 200
1-24-76
1-24

166

1976 J.T. Madeline

Tippah

date well completed

firm name

county well located

LANDOWNER:

Cecil Jones

description of formations encountered

from

to

Hy-379 Ashland
(mailing address)

sand + clay

10 100

WELL LOCATION:

sec. 150-3 N 24 E
6 miles East of Jackson
(distance) (direction) (nearest town)

clay

100 160

sand + shell

160 200

WELL PURPOSE:

(home, irrigation, municipal, industrial)

WELL COMPLETION DATA:

- (1) diameter (inches) 4"
- (2) total depth (feet) 200
- (3) static water level (feet) 160 below top of ground.
- (4) casing Plastic 200
(material) (depth)
4 in. if telescope see back.
(size)
- (5) screen 1 1/2" 190
(length) (depth to top)
4" (size) Plastic (material)
- (6) pump 3/4 3-8
(HP) (yield gpm)
Electric (type power)
- (7) electric log _____
(yes or no)


(organization running log)
- (8) how well bottom plugged Plastic cap

DRILLERS REMARKS:

RECEIVED
FEB 24 1976
MISS. Bd. OF WATER COMM.

If well telescopes please sketch and show depths.

GROUND LEVEL

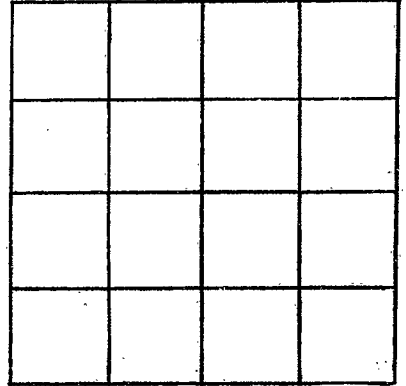

SECTION _____

Please indicate well location X.

ADDITIONAL INFORMATION

If more than one screen, show locations of each on sketch.