

Tippah
 F 2002
 10/27/76

MISSISSIPPI
 BOARD OF WATER COMMISSIONERS
 416 North State Street
 Jackson, Mississippi 39201

WATER WELL DRILLERS LOG

OCT 27
 date well completed

1976 Billy R. STAMPSON
 firm name

TIPPAAH
 county well located

LANDOWNER:
 ROBT. L. GOOLSBY
 FALKNER, MISS
 (mailing address)

WELL LOCATION:
 sec. 30 T. 3 S. R. 4 E.
 4 miles S of FALKNER
 (distance) (direction) (nearest town)

WELL PURPOSE: None
 (home, irrigation, municipal, industrial)

WELL COMPLETION DATA:

(1) diameter (inches) 4

(2) total depth (feet) 235

(3) static water level (feet) 73 below above top of ground.

(4) casing 102 110 (material) (depth)
 (size) if telescope see back.

(5) screen NONE (length) (depth to top)
 (size) (material)

(6) pump 3/4 10 (HP) (yield gpm)
 Elec (type power)

(7) electric log No (yes or no)
 (organization running log)

(8) how well bottom plugged NONE

description of formations encountered	from	to
SANDSTONE CLAY	0	10
BLACK SAND & CLAY	10	23
BLUE CLAY	23	45
ROCK	45	46
Blue CLAY	46	52
LIMESTONE & SAND	52	76
BLUE CLAY	76	109
ROCK	109	180
BLUE CLAY	110	113
LIMESTONE & SAND	113	235


RECEIVED

DEC 29 1976

DRILLERS REMARKS:

If well telescopes please sketch and show depths.

GROUND LEVEL

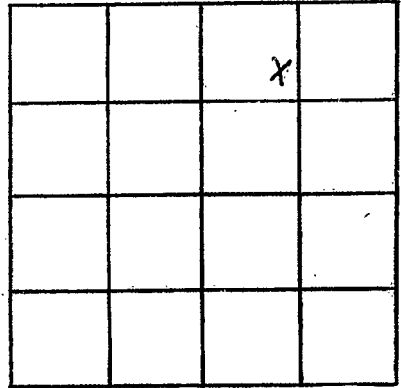

SECTION 50

Please indicate well location X.

ADDITIONAL INFORMATION

If more than one screen, show locations of each on sketch.