

Tippah
 F 2004
 5/30/77

MISSISSIPPI
 BOARD OF WATER COMMISSIONERS
 416 North State Street
 Jackson, Mississippi 39201

WATER WELL DRILLERS LOG

May 30 1977 ¹⁶⁶ Betty R. Scarpso Tippah
 date well completed firm name county well located

LANDOWNER:
 MRS ELMA THRASHER
 FALKNER MISS
 (mailing address)

description of formations encountered	from	to
SURFACE CLAY	0	5
SAND	5	40
Blue CLAY	40	59
ROCK	59	60
Blue CLAY	60	70
YELLOW ROCK	70	80
YELLOW SAND	80	128
LIME STONE	128	132
SAND & ROCK	132	190

WELL LOCATION:
 sec. 5 T 3 N R 4 E
 S E of FALKNER
 4 miles (distance) (direction) (nearest town)

WELL PURPOSE: HOME
 (home, irrigation, municipal, industrial)

WELL COMPLETION DATA:

(1) diameter (inches) 4

(2) total depth (feet) 190

(3) static water level (feet) 110 below top of ground above

(4) casing (material) POC (depth) 170

(size) If telescope see back.

(5) screen (length) 20 (depth to top) 170
 (size) 4" (material) POC

(6) pump (HP) 1/2 (yield gpm) 5
 (type power) Elec

(7) electric log No (yes or no)

(organization running log)

(8) how well bottom plugged POC CAP


RECEIVED

NOV 11 1977

DRILLERS REMARKS: MISS. BD. OF WATER COMMISSIONERS

If well telescopes please sketch and show depths.

GROUND LEVEL

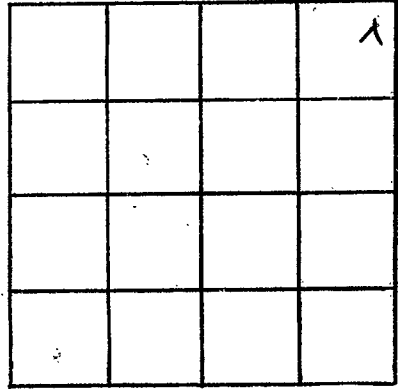

SECTION 5

Please indicate well location X.

ADDITIONAL INFORMATION

If more than one screen, show locations of each on sketch.