

Tippah
 F 2005
 10-15-77

MISSISSIPPI
 BOARD OF WATER COMMISSIONERS
 416 North State Street
 Jackson, Mississippi 39201

WATER WELL DRILLERS LOG


10-15- date well completed 1977 Bryants Well Drilling firm name Tippah county well located

LANDOWNER:
 Harold Brock
 FALKNER MS.
 (mailing address)

description of fomations encountered	from	to
CLAY	0	25
CLAY & ROCK	25	60
Blue CLAY	60	130
sand & rock	130	180

WELL LOCATION:
 sec. 5 T 3 N R. 4 E
 S W
 42+ miles NEAST of FALKNER
 (distance) (direction) (nearest town)

WELL PURPOSE: NONE
 (home, irrigation, municipal, industrial)

- WELL COMPLETION DATA:
- (1) diameter (inches) 4"
 - (2) total depth (feet) 180'
 - (3) static water level (feet) 75' below top of ground.
 - (4) casing PLAS. 100'
 (material) (depth)
 - (size) if telescope see back.
 - (5) screen (length) (depth to top)
 - (size) (material)
 - (6) pump 2 sub. 10
 (HP) (yield gpm)
 - (type power)
 - (7) electric log (yes or no)
 - (organization running log) OPEN
 - (8) how well bottom plugged 


RECEIVED
 NOV 21 1977

MISS. BD. OF WATER COMMISSIONERS

DRILLERS REMARKS:

If well telescopes please sketch and show depths.

GROUND LEVEL

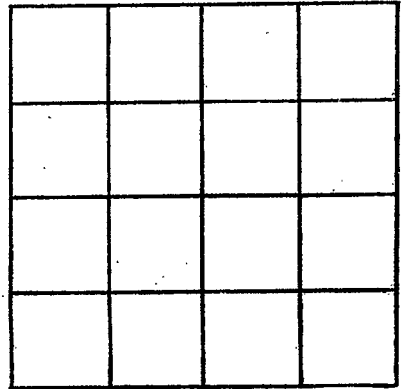

SECTION _____

Please indicate well location X.

ADDITIONAL INFORMATION

If more than one screen, show locations of each on sketch.