

Tippah
 F 2000
 10-18-77

MISSISSIPPI
 BOARD OF WATER COMMISSIONERS
 416 North State Street
 Jackson, Mississippi 39201

WATER WELL DRILLERS LOG

10-18 date well completed 1977 Bryants Well Drilling Tippah firm name Tippah county well located

LANDOWNER:
 LESLIE GREEN
 FALKNER MS.
 (mailing address)

description of formations encountered	from	to
CLAY	0	30
CLAY & ROCK	30	120
SAND & ROCK	120	160

WELL LOCATION:
 sec. 5 T. 3 N. R. 4 E.
 5 2 1/2 miles N. EAST of FALKNER
 (distance) (direction) (nearest town)

WELL PURPOSE: HOME
 (home, irrigation, municipal, industrial)

WELL COMPLETION DATA:

(1) diameter (inches) 4"

(2) total depth (feet) 160'

(3) static water level (feet) 90' (below above top of ground)

(4) casing P.I.A.S. 160'
 (material) (depth)
 013" if telescope see back.
 (size)

(5) screen 10' 150'
 (length) (depth to top)
 4" P.I.A.S.
 (size) (material)

(6) pump 1/2 H.P. 7
 (HP) (yield gpm)

(type power)

(7) electric log (yes or no)

(organization running log)

(8) how well bottom plugged P.I.A.S. CAP.


RECEIVED
 NOV 21 1977

MISS. BD. OF WATER COMMISSIONERS

DRILLERS REMARKS:

If well telescopes please sketch and show depths.

GROUND LEVEL

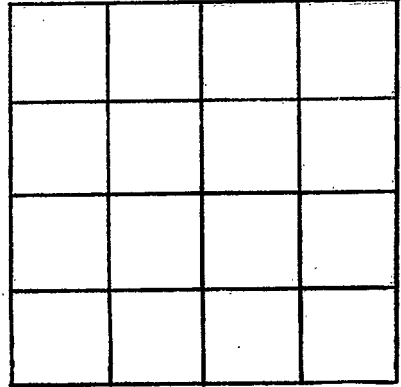

SECTION _____

Please indicate well location X.

ADDITIONAL INFORMATION

If more than one screen, show locations of each on sketch.