

Tippah
 F 2007
 10-24-77

MISSISSIPPI
 BOARD OF WATER COMMISSIONERS
 416 North State Street
 16L Jackson, Mississippi 39201

WATER WELL DRILLERS LOG

Oct 24 1977 Billy R Simpson TIPPAAH
 date well completed firm name county well located

| LANDOWNER: | description of formations encountered | from | to |
|---|---------------------------------------|------------|------------|
| <u>LUCIAN CAMPBELL</u> | | | |
| <u>FALKNER, MISS</u> (mailing address) | <u>YELLOW CLAY</u> | <u>4</u> | <u>18</u> |
| | <u>SAND</u> | <u>18</u> | <u>50</u> |
| | <u>ROCK</u> | <u>50</u> | <u>58</u> |
| | <u>BLUE CLAY</u> | <u>58</u> | <u>86</u> |
| | <u>ROCK + CLAY (YELLOW)</u> | <u>86</u> | <u>108</u> |
| | <u>YELLOW SAND</u> | <u>108</u> | <u>142</u> |
| | <u>LIMESTONE</u> | <u>142</u> | <u>158</u> |
| | <u>YELLOW ROCK + SAND</u> | <u>158</u> | <u>190</u> |
| | <u>WHITE SAND</u> | <u>190</u> | <u>235</u> |

WELL LOCATION:
 sec 3 T 3 R 4 E
4 miles E of FALKNER
 (distance) (direction) (nearest town)

WELL PURPOSE: HOME
 (home, irrigation, municipal, industrial)

- WELL COMPLETION DATA:
- (1) diameter (inches) 4
 - (2) total depth (feet) 235
 - (3) static water level (feet) 119 below above ground.
 - (4) casing PVC, 174,
 (material) (depth)
 - if telescope see back.
 (size)
 - (5) screen NONE,
 (length) (depth to top)
 - (size) (material)
 - (6) pump 1/2 JET 6
 (HP) (yield gpm)
 - ELEC
 (type power)
 - (7) electric log NO
 (yes or no)
 - (organization running log)
 - (8) how well bottom plugged NONE


DRILLERS REMARKS:

RECEIVED
 NOV 11 1977

MISS. BD. OF WATER COMMISSIONERS

If well telescopes please sketch and show depths.

GROUND LEVEL

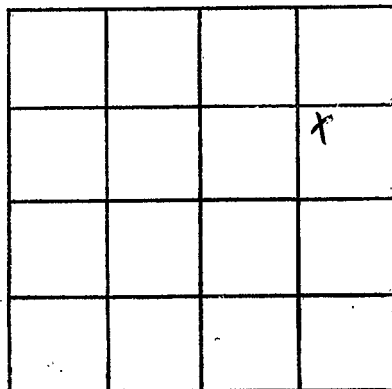

SECTION 3

Please indicate well location X.

ADDITIONAL INFORMATION

If more than one screen,
show locations of each on sketch.