

Tippah
 F 2008
 5-18-79

MISSISSIPPI
 BOARD OF WATER COMMISSIONERS
 416 North State Street
 Jackson, Mississippi 39201

WATER WELL DRILLERS LOG

5-18 1979 Robert W. Wilson Tippah
 date well completed firm name county well located

LANDOWNER:	description of formations encountered	from	to
M. Meddie Jackson Rt. 3 Walnut, MISS (mailing address)			
WELL LOCATION: sec. 17 T. 3 N. R. 4 E (distance) miles (direction) of (nearest town)			
WELL PURPOSE: (home, irrigation, municipal, industrial)			
WELL COMPLETION DATA:			
(1) diameter (inches) 4			
(2) total depth (feet) 120			
(3) static water level (feet) 35 below top of ground.			
(4) casing Pul (material) (depth)			
(size) If telescope see back.			
(5) screen 10 (length) 110 (depth to top)			
4 (size) gravel packed (material)			
(6) pump 3/4 (HP) 10 (yield gpm)			
(type power)			
(7) electric log (yes or no)			
(organization running log)			
(8) how well bottom plugged 4" plastic cap			
DRILLERS REMARKS:			


Miss. Board of Water Comm.

MAY 30 1979

RECEIVED

If well telescopes please sketch and show depths.

GROUND LEVEL

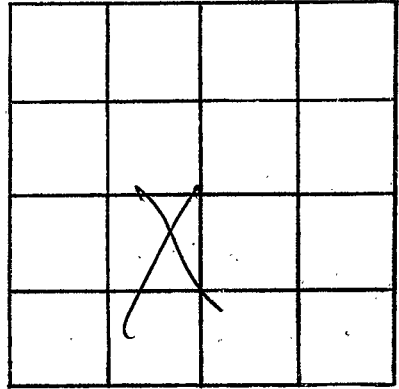

SECTION 17

Please indicate well location X.

ADDITIONAL INFORMATION

If more than one screen, show locations of each on sketch.