

TIPPAH

F 2008

5/23/79

MISSISSIPPI BOARD OF WATER COMMISSIONERS  
416 North State Street  
Jackson, Mississippi 39201

WATER WELL DRILLERS LOG

5-28-19 date well completed

79 J.T. Medlin firm name

Tippan county/well located

LANDOWNER: Mrs. Dillard

Replay MS.  
Rt 4

(mailing address)

description of formations encountered

from to

Clay 0 160  
Rock & sand 160 280

WELL LOCATION:

sec. 4 T 3 N R 4 E  
S W  
5 miles NE of Replay  
(distance) (direction) (nearest town)

WELL PURPOSE:

(home, irrigation, municipal, industrial)

WELL COMPLETION DATA:

- (1) diameter (inches) 4
- (2) total depth (feet) 280
- (3) static water level (feet) 120 above top of ground.
- (4) casing P 160 (material) (depth)
- (size) If telescope see back.
- (5) screen 12 270 (length) (depth to top)
- (size) (material)
- (6) pump 1/2 7 (HP) (yield gpm)
- E (type power)
- (7) electric log (yes or no)

(organization running log)

(8) how well bottom plugged open

DRILLERS REMARKS:


Miss. Board of Water Comm.

AUG 16 1979

RECEIVED

If well telescopes please sketch and show depths.

GROUND LEVEL

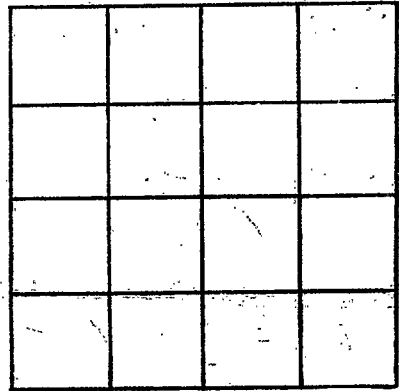

SECTION \_\_\_\_\_

Please indicate well location X.

ADDITIONAL INFORMATION

If more than one screen, show locations of each on sketch.