

TIPPAAH
 F 2010
 5-10-81

MISSISSIPPI
 BOARD OF WATER COMMISSIONERS
 416 North State Street
 Jackson, Mississippi 39201

WATER WELL DRILLERS LOG

5-10-81 19 J. T. Medlin Tippaah
 date well completed firm name county well located

LANDOWNER:
 Chester Crum, Jr.
 Murry Spur Rd.
 Ripley, Miss (mailing address) 38663

description of formations encountered	from	to
Mixed CLAY	0	100
Blue CLAY	100	140
Blue CLAY mixed with ROCK	140	390
Blue CLAY, SAND, Shell, AND ROCK	390	400

WELL LOCATION:
 sec 31 T 1 N R 3 E
 2 1/2 miles 4 S NE of Ripley
 (distance) (direction) (nearest town)

WELL PURPOSE: Home
 (home, irrigation, municipal, industrial)


- WELL COMPLETION DATA:
- (1) diameter (inches) 4
 - (2) total depth (feet) 400
 - (3) static water level (feet) 100 below above
top of ground.
 - (4) casing PVC 190
(material) (depth)
____ (size) If telescope see back.
 - (5) screen _____
(length) (depth to top)
____ (size) _____ (material)
 - (6) pump 1/2 12
(HP) (yield gpm)
Elec.
(type power)
 - (7) electric log _____
(yes or no)
____ (organization running log)
 - (8) how well bottom plugged _____

DRILLERS REMARKS:

DEPT. OF NATURAL RESOURCES
 BUREAU OF LAND & WATER RESOURCES
 MAY 29 1981
 RECEIVED

If well telescopes please sketch and show depths.

GROUND LEVEL

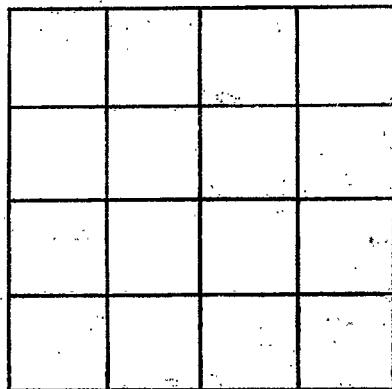

SECTION _____

Please indicate well location X.

ADDITIONAL INFORMATION

If more than one screen, show locations of each on sketch.