

MISSISSIPPI DEPARTMENT OF NATURAL RESOURCES
Bureau of Land and Water Resources
 Southport Mall
 P.O. Box 10631
 Jackson, Mississippi 39209
WATER WELL DRILLERS LOG

Tippah
FOOD

8-24 date well completed 1983 Wilson Well Co. Inc firm name Tippah county well located

LANDOWNER: Larry Meeks
Route 3
Ripley, Miss
 (mailing address)

description of formations encountered	from	to
<u>Red Sand</u>	<u>0</u>	<u>30</u>
<u>Brown Sand</u>	<u>30</u>	<u>90</u>
<u>Rock</u>	<u>90</u>	<u>92</u>
<u>White Clay</u>	<u>92</u>	<u>94</u>
<u>Brown Sand</u>	<u>94</u>	<u>165</u>

WELL LOCATION:
 sec. 9 T. 3 N. R. 4 E
4 miles E of Falkner
 (distance) (direction) (nearest town)

WELL PURPOSE: Home
 (home, irrigation, municipal, industrial)

WELL COMPLETION DATA:

(1) diameter (inches) 4

(2) total depth (feet) 165

(3) static water level (feet) 65 below above top of ground.

(4) casing 4 165
 (material) (depth)
4 if telescope see back.
 (size)

(5) screen Ø10 PLASTIC
 (length) (depth to top)
4 (size) (material)

(6) pump 34 8
 (HP) (yield gpm)
Electric
 (type power)

(7) electric log NO
 (yes or no)

(organization running log)

(8) how well bottom plugged 4"
PLASTIC CAP

DRILLERS REMARKS:


DEPT. OF NATURAL RESOURCES
 BUREAU OF LAND & WATER RESOURCES

SEP 19 1983

RECEIVED

If well telescopes please sketch and show depths.

GROUND LEVEL

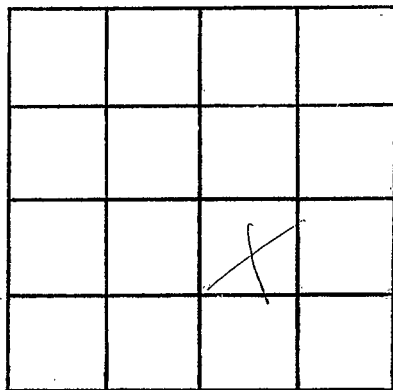

SECTION 9

Please indicate well location X.

ADDITIONAL INFORMATION

If more than one screen, show locations of each on sketch.