

MISSISSIPPI DEPARTMENT OF ENVIRONMENTAL QUALITY

Office of Land and Water Resources

P. O. Box 10631  
Jackson, MS 39289-0631  
WATER WELL DRILLERS LOG

COUNTY WELL LOCATED  
Leflore

WELL NUMBER  
F-2014

CODED

DATE WELL COMPLETED  
6-26-02

PERMIT NUMBER

NAME OF DRILLING FIRM  
Medley

NAME & MAILING ADDRESS OF LANDOWNER  
Rebecca James  
380A CR 508  
Ripley MS 38663

Latitude: 33° 50'  
Longitude: 34° 47'

WELL LOCATION. SEC 27 TOWNSHIP T3 RANGE N R4 (E)  
(W)

DISTANCE 8 MILES DIRECTION NE of NEAREST TOWN Ripley

OTHER LANDMARK

WELL PURPOSE Home Irrigation, Municipal, Industrial, Fish Pond, etc.

PUMP DATA

PUMP TYPE (Circle One):  
Submersible Turbine, Jet, Flowing Well,  
Other (Describe)

POWER TYPE (Circle One):  
Electric Tractor, Diesel, Gasoline 3 Butane,  
Other (Describe) H/P 4

DESCRIPTION OF FORMATIONS ENCOUNTERED	FROM	TO
<u>top soil</u>		
<u>white, yellow</u>		
<u>clay mix</u>	<u>0</u>	<u>80</u>
<u>Rock clay</u>		
<u>mix</u>	<u>80</u>	<u>120</u>
<u>water sand</u>		
<u>(yellow)</u>		
<u>aquifer</u>	<u>120</u>	<u>140</u>

RECEIVED  
JUL 15 2002  
D.V. OLIVER  
Top of Lap Pipe or Reduction in Casing  
FEET IF TELESCOPED OR MORE THAN ONE SCREEN: USE BACK PAGE

WELL DATA

Well Depth <u>140</u>	Casing Diameter (In.) <u>4"</u>	Casing Length (Ft.) <u>130</u>
Type of Casing <u>PVC</u>	Hole Depth <u>140</u>	Depth to Static Water Level <u>70'</u>

TYPE OF COMPLETION: (Circle One or More):  
Gravel Packed, Underreamed, Telescoped,  
Natural Development, Open Hole, Other  
(Describe) 80 screen gravel pack

WELL GROUTED TO A DEPTH OF 12 FEET  
Type Grout (circle one): Cement, Bentonite, or Mix

SCREEN DATA

Diameter - Inches <u>4</u>	Length - Feet <u>10</u>	Slot Size - Inches <u>0.13</u>
Screen Type <u>PVC</u>	Depth to Bottom - Feet <u>130-140</u>	


I certify that the well was drilled, constructed and completed in accordance with all applicable Requirements of the Mississippi Department of Environmental Quality and/or the Mississippi Department of Health regulations and state laws.

Jamoo R. Mulla 0429 6-26-02  
Signature of Licensed Driller and License No. Date

Additional Information Required On Back

If well telescopes please sketch and show depths.

GROUND LEVEL

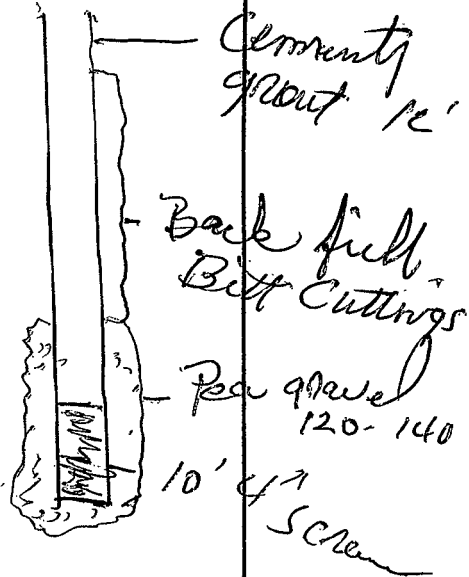

		X	

SECTION 27

Please indicate well location X.

Pump Capacity (GPM)	No. of Stages	Setting Depth	
12	10	110	FT.
PUMP TEST			
Well yielded <u>12</u> GPM with			
a drawdown of <u>6</u> ft.			
after <u>6</u> hours of pumping			

LOG DATA

TYPE OF LOG RUN (Circle One): No Log Run.  
 Electric, Gamma Ray, Density, Sonic, Neutron, Other (Describe) \_\_\_\_\_

Name of Organization Running Log \_\_\_\_\_

GEOLOGIC DATA (Office Use Only)

Surface Elev.	Geologic Unit	Unit Thickness	Depth to Top
Subs. SWL	Date	Analysis	Aquifer Test

Driller's Remarks

---



---



If more than one screen, show location of each on sketch.