

Tippah
 G4
 12-66

MISSISSIPPI
 BOARD OF WATER COMMISSIONERS
 416 North State Street
 Jackson, Mississippi 39201

WATER WELL DRILLERS LOG

Dec 23 1966 date well completed
 Jumper Well Co. Tippah firm name
 Tippah county well located

LANDOWNER:
 Lamont Richardson
 Ripley, Miss.
 (mailing address)

description of formations encountered	from	to
sand & rock	0	140
water bearing sand		
formation	140	180
Blue clay	180	190


WELL LOCATION:
 sec. 31 T. 35 N. R. 5 E. E
 S W
 12 miles East of Ripley
 (distance) (direction) (nearest town)

WELL PURPOSE: home
 (home, irrigation, municipal, industrial)

WELL COMPLETION DATA:


(1) diameter (inches) 4"
 (2) total depth (feet) 190
 (3) static water level (feet) 400 below top of ground.
 (4) casing PVC, 190' (material) (depth)
 4" (size) if telescope see back.
 (5) screen 15' (length), 160' (depth to top)
 1/32" PVC + gravel (size) (material)
 (6) pump 2 (HP), 18 (yield gpm)
 electric (type power)
 (7) electric log NO (yes or no)
 (organization running log)
 (8) how well bottom plugged none

DRILLERS REMARKS:

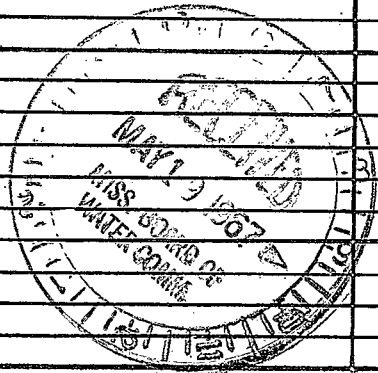

If well telescopes please sketch and show depths.

GROUND LEVEL

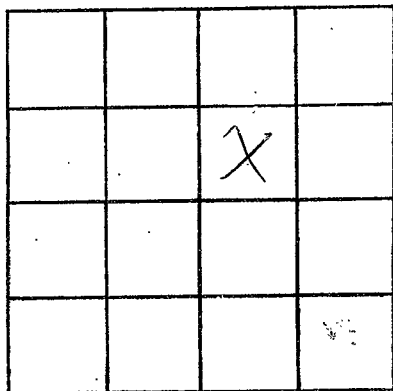

SECTION _____

Please indicate well location X.

ADDITIONAL INFORMATION

If more than one screen,
show locations of each on sketch.