

MISSISSIPPI
BOARD OF WATER COMMISSIONERS
416 North State Street
Jackson, Mississippi 39201

CODED

WATER WELL DRILLERS LOG

TIPPAN
G5
Elog #16

July 1977 date well completed
J. W. Webb & Sons firm name
Tippah county well located

LANDOWNER:	description of formations encountered	from	to
Spout Springs	Soil	0	1
Water Assn.	Sand & Clay	1	30
(mailing address)	Blue Rock	30	160
WELL LOCATION:	Blue Rock Shells	160	180
sec. 33 T3 N R 5 E	Sand & Blue Rock	180	220
S W	Soft Blue Rock & Sand	220	240
(distance) miles (direction) of (nearest town)	Sand	240	260
WELL PURPOSE:	Sand & Blue Rock	260	340
(home, irrigation, municipal, industrial)	Blue Rock & Sand	340	630
WELL COMPLETION DATA:	Water Sand	630	685
(1) diameter (inches) 4	4 gal per ft		
(2) total depth (feet) 685			
(3) static water level (feet) 270 below top of ground			
(4) casing (material) Steel (depth) 620			
(5) screen (size) 8 (length) 50ft (depth to top) 630			
(6) pump (size) 4" (material) Stainless Steel (HP) 15 turbine (yield gpm) 100 at 60psi			
(type power) Elec			
(7) electric log (yes or no) Yes			
(organization running log) U.S.H.S.			
(8) how well bottom plugged Back wash valve			
DRILLERS REMARKS:			


CODED

REC 91 1072

(4)

If well telescopes please sketch and show depths.

GROUND LEVEL

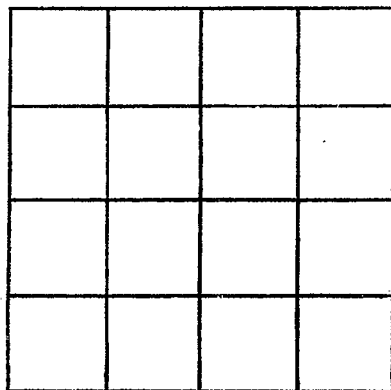

SECTION _____

Please indicate well location X.

ADDITIONAL INFORMATION

A series of 20 horizontal lines for recording additional information.

If more than one screen, show locations of each on sketch.