

TIPPAH
G 2000
4-30-77

**MISSISSIPPI
BOARD OF WATER COMMISSIONERS**
416 North State Street
Jackson, Mississippi 39201

WATER WELL DRILLERS LOG

4-30 1977 Bond Well Drilling Tippah
 date well completed firm name county well located

LANDOWNER Ernest Arnold
Kossuth
 (mailing address)

description of formations encountered	from	to
Red Clay	0	15
Yellow Sand	15	30
Blue Clay	30	290
Water Sand	290	350

WELL LOCATION:
 sec. 8 T. 3 N R. 5 E
6 miles SE of Kossuth
 (distance) (direction) (nearest town)

WELL PURPOSE: Home
 (home, irrigation, municipal, industrial)

WELL COMPLETION DATA:

(1) diameter (inches) 4"

(2) total depth (feet) 350'

(3) static water level (feet) 70 below above top of ground.

(4) casing Plastic, 40'
 (material) (depth)
 (size) if telescope see back.

(5) screen no
 (length) (depth to top)
 (size) (material)

(6) pump 3/4 10 gpm
 (HP) (yrbld gpm)
elect
 (type power)

(7) electric log no
 (yes or no)
 (organization running log)


(8) how well bottom plugged open

DRILLERS REMARKS:

RECEIVED
DEC - 7 1978
 MISS. BD. OF WATER COMMISSIONERS

If well telescopes please sketch and show depths.

GROUND LEVEL

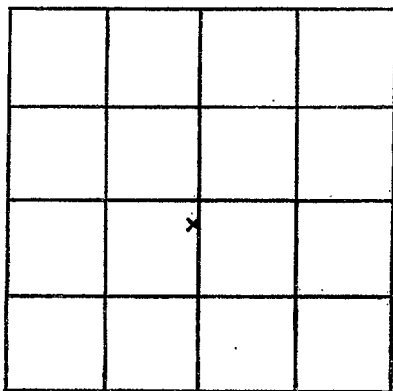

SECTION _____

Please indicate well location X.

ADDITIONAL INFORMATION

If more than one screen,
show locations of each on sketch.