

TIPPAH
 H-6
~~7-5-71~~
 7-5-71
 7-5

MISSISSIPPI
 BOARD OF WATER COMMISSIONERS
 416 North State Street
 Jackson, Mississippi 39201

\$ 570.00
 2850
 \$ 598.50
CODED

WATER WELL DRILLERS LOG

19 7-5 date well completed

21 J T Medlin firm name

Tippah county well located

LANDOWNER:
Shand Gaishans
Ripley R# 4
 (mailing address)

description of formations encountered	from	to
<u>White clay</u>	<u>0</u>	<u>23</u>
<u>Blue "</u>	<u>23</u>	<u>255</u>
<u>Rock</u>	<u>255</u>	<u>360</u>

WELL LOCATION:
 sec. 3 T. 4 N. R. 2 E
6 miles East of Ripley
 (distance) (direction) (nearest town)

WELL PURPOSE:
 (home, irrigation, municipal, industrial)

- WELL COMPLETION DATA:
- (1) diameter (inches) 4-3/8
 - (2) total depth (feet) 360
 - (3) static water level (feet) 6 below top of ground.
 - (4) casing P 90
 (material) (depth)
 (size) if telescope see back.
 - (5) screen _____
 (length) (depth to top)
 (size) (material)
 - (6) pump _____
 (HP) (yield gpm)
 (type power)
 - (7) electric log (yes or no) _____
 (organization running log) _____
 - (8) how well bottom plugged _____

CODED


AUG 4 - 197

DRILLERS REMARKS:

MISS. BD. OF
 WATER COMM.

If well telescopes please sketch and show depths.

GROUND LEVEL

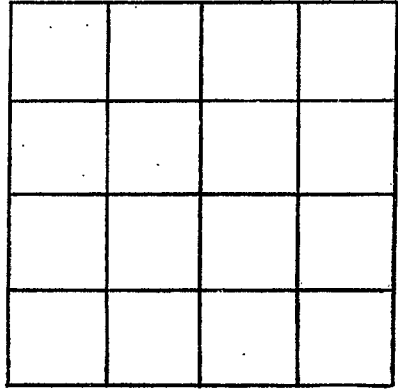

SECTION _____

Please indicate well location X.

ADDITIONAL INFORMATION

If more than one screen,
show locations of each on sketch.