

TIPPANH
H 8
6-26-79

MISSISSIPPI
BOARD OF WATER COMMISSIONERS
416 North State Street
Jackson, Mississippi 39201

WATER WELL DRILLERS LOG

JUNE 26 1979 of Billy R. Simpson TIPPANH
date well completed firm name county well located

LANDOWNER:

Billy PEELER
RIPLEY Ms.
(mailing address)

description of formations encountered

description of formations encountered	from	to
SURFACE CLAY	0	18
SAND	18	26
BLUE CLAY	26	140
LIME STONE	140	185
BLUE CLAY	185	195
LIME STONE	195	215
BLUE CLAY	215	240
LIME STONE	240	282

WELL LOCATION:

sec. 13 T 4 S R 2 E
6 miles W of RIPLEY
(distance) (direction) (nearest town)

WELL PURPOSE: HOME
(home, irrigation, municipal, industrial)

WELL COMPLETION DATA:

- (1) diameter (inches) 4
- (2) total depth (feet) 282
- (3) static water level (feet) 18 below above top of ground.
- (4) casing POC 70
(material) (depth)
(size) if telescope see back.
- (5) screen NONE
(length) (depth to top)
(size) (material)
- (6) pump 1/2 8
(HP) (yield gpm)
ELEC
(type power)
- (7) electric log No
(yes or no)
(organization running log)
- (8) how well bottom plugged


RESERVED
JUL - 8 1979

DRILLERS REMARKS:

MISS. BD. OF WATER COMM

If well telescopes please sketch and show depths.

GROUND LEVEL

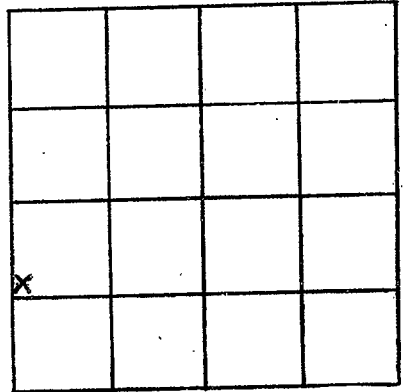

SECTION 13

Please indicate well location X.

ADDITIONAL INFORMATION

If more than one screen,
show locations of each on sketch.