

TIPPAN  
H9  
8-3-74

MISSISSIPPI  
BOARD OF WATER COMMISSIONERS  
416 North State Street  
Jackson, Mississippi 39201

CODED

WATER WELL DRILLERS LOG

83 1974 JT Medley Tippah  
date well completed firm name county well located

LANDOWNER: Ball Street  
Ripley H W &  
West.  
(mailing address)

description of formations encountered	from	to
clay & sand	0	86
level clay	86	320
rock & sand	320	480

WELL LOCATION:  
sec. 14 T 4 N R 2 E  
6 miles W of Blue Hill  
(distance) (direction) (nearest town)

WELL PURPOSE:  
(home, irrigation, municipal, industrial)

- WELL COMPLETION DATA:
- (1) diameter (inches) 4
  - (2) total depth (feet) 480
  - (3) static water level (feet) 30 below top of ground.
  - (4) casing P 160 (material) (depth)
  - (size) if telescope see back.
  - (5) screen (length) (depth to top)
  - (size) (material)
  - (6) pump 1/2 10 (HP) (yield gpm)
  - (type power)
  - (7) electric log (yes or no)
  - (organization running log)
  - (8) how well bottom plugged

CODED


RECEIVED

AUG 15 1974

DRILLERS REMARKS:

If well telescopes please sketch and show depths.

GROUND LEVEL

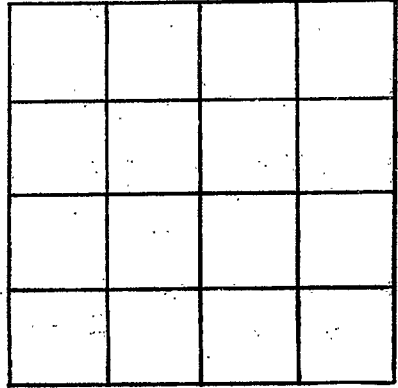

SECTION \_\_\_\_\_

Please indicate well location X.

ADDITIONAL INFORMATION

If more than one screen, show locations of each on sketch.