

TIPPAN
 H 10
 8-15-74

MISSISSIPPI
 BOARD OF WATER COMMISSIONERS
 416 North State Street
 Jackson, Mississippi 39201

CODED

WATER WELL DRILLERS LOG

AUG 15 1974 Billy R. SIMPSON TIPPAN
 date well completed firm name county well located

LANDOWNER:	description of formations encountered	from	to
MRS. M. J. SMITH	SURFACE CLAY	0	24
Ripley Ms.	SAND	24	34
(mailing address)	BLUE CLAY	34	145
	ROCK	145	147
	BLUE CLAY	147	156
	LIME STONE + SAND	156	212
	BLUE CLAY	212	240
	LIME STONE + SAND	240	278

WELL LOCATION:
 sec. 13 T 4 N R 2 E
 S 4
 5 miles W of Ripley
 (distance) (direction) (nearest town)

WELL PURPOSE: NONE
 (home, irrigation, municipal, industrial)


- WELL COMPLETION DATA:
- (1) diameter (inches) 4
 - (2) total depth (feet) 278
 - (3) static water level (feet) 20 below top of ground.
 - (4) casing PVC, 72 (material) (depth)
 - (5) screen None (length) (depth to top)
 - (6) pump 1/2 (HP) 7 (material) (yield gpm)
 - (7) electric log No (type power) (yes or no)
 - (8) how well bottom plugged

RECEIVED
 SEP 20 1974

DRILLERS REMARKS:

If well telescopes please sketch and show depths.

GROUND LEVEL

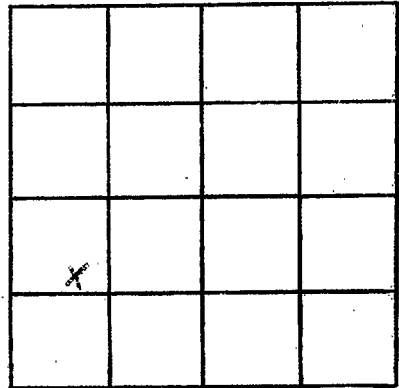

SECTION 13

Please indicate well location X.

ADDITIONAL INFORMATION

If more than one screen,
show locations of each on sketch.