

Tippah
 H11
 5-8-75

MISSISSIPPI
 BOARD OF WATER COMMISSIONERS
 416 North State Street
 Jackson, Mississippi 39201

WATER WELL DRILLERS LOG

CODED
 TIPPAH

MAY 8 1975 Billy R. Simpson firm name date well completed county well located

LANDOWNER: F.T. SMITH
 J.E. BROTHERTON
 RIPLEY, MS
 (mailing address)

WELL LOCATION:
 sec. 1 T 4 N R 2 E 15F
 7 miles W of RIPLEY
 (distance) (direction) (nearest town)

description of formations encountered	from	to
SURFACE CLAY	0	17
ROCK	17	18
WHITE CLAY + SAND	18	40
SAND	40	82
ROCK	82	83
BLUE CLAY	83	270
BLUE CLAY + SAND	270	282
LIME STONE + SAND	282	347
BLUE CLAY	347	374
LIME STONE + SAND	374	426

WELL PURPOSE: HOME
 (home, irrigation, municipal, industrial)

WELL COMPLETION DATA:

(1) diameter (inches) 4

(2) total depth (feet) 424

(3) static water level (feet) 137 below top of ground.

(4) casing PVC, 176 (material) (depth)

(size) If telescope see back.

(5) screen None (length) (depth to top)

(size) (material)

(6) pump 3/4 10 (HP) (yield gpm)

Elec (type power)

(7) electric log NO (yes or no)

(organization running log)

(8) how well bottom plugged


DRILLERS REMARKS:

DEPARTMENT OF
 JUN 11 1975

MISS. BD. OF WATER COMMISSIONERS

If well telescopes please sketch and show depths.

GROUND LEVEL

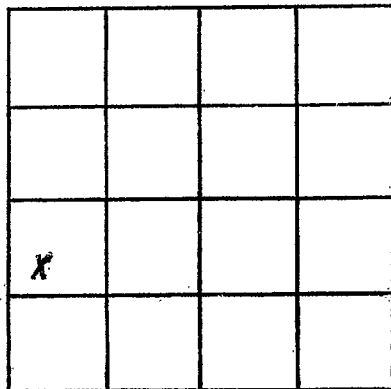

SECTION 1

Please indicate well location X.

ADDITIONAL INFORMATION

If more than one screen,
show locations of each on sketch.