

Tippah  
 H/3  
 7-14-75

MISSISSIPPI  
 BOARD OF WATER COMMISSIONERS CODED  
 416 North State Street  
 Jackson, Mississippi 39201

WATER WELL DRILLERS LOG

July 14 1975 Billy R. Simpson Tippah  
 date well completed firm name county well located

LANDOWNER:  
 JOHNNY CARTER  
 Blue Mountain, Miss  
 (mailing address)

WELL LOCATION:  
 sec 22 T 4 N R 2 E 15F  
 S #  
 7 miles W of Ripley  
 (distance) (direction) (nearest town)

WELL PURPOSE: Home  
 (home, irrigation, municipal, industrial)

WELL COMPLETION DATA:  
 (1) diameter (inches) 4  
 (2) total depth (feet) 280  
 (3) static water level (feet) 10 below above top of ground.  
 (4) casing PVC 68 (material) (depth)  
 (size) if telescope see back.  
 (5) screen None (length) (depth to top)  
 (size) (material)  
 (6) pump 1/2 7 (HP) (yield gpm)  
 Elec (type power)  
 (7) electric log No (yes or no)  
 (organization running log)  
 (8) how well bottom plugged

description of formations encountered	from	to
Surface Clay	0	16
SAND	16	46
Blue Clay	46	150
Rock	150	157
Blue Clay	157	175
LIME STONE + SAND	175	215
Blue Clay	215	232
LIME STONE + SAND	232	280

RECEIVED


AUG 18 1975

DRILLERS REMARKS:

MISS. Bd. OF WATER COMMISSIONERS

If well telescopes please sketch and show depths.

GROUND LEVEL

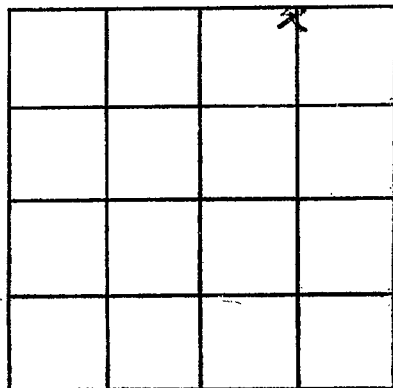

SECTION 22

Please indicate well location X.

ADDITIONAL INFORMATION

If more than one screen,  
show locations of each on sketch.