

MISSISSIPPI DEPARTMENT OF NATURAL RESOURCES  
 Bureau of Land and Water Resources  
 Southport Mall  
 P.O. Box 10631  
 Jackson, Mississippi 39209  
**WATER WELL DRILLERS LOG**

CODED

TIPPAH  
 H16  
 1-1-86

JAN 1 1986 J. W. WEBB & SONS INC TIPPAH  
 date well completed firm name county well located

LANDOWNER: SHADY GROVE DEVELOPMENT ASSOC.  
 (mailing address)

description of formations encountered	from	to
RED SAND & CLAY	0	30
SANDY CLAY	30	210
CLAY & ROCK	210	300
SAND & ROCK	300	560
CLAY	560	940
SAND	940	1030

WELL LOCATION:  
 sec. 12 T 4 N R 2 E S S W  
 4 miles WEST of RIPLEY  
 (distance) (direction) (nearest town)

WELL PURPOSE:  
 (home, irrigation, municipal, industrial)

WELL COMPLETION DATA:

(1) diameter (inches) 10

(2) total depth (feet) 1030

(3) static water level (feet) 218 below top of ground.

(4) casing STEEL 953  
 (material) (depth)

(size) if telescope see back.

(5) screen 50 965  
 (length) (depth to top)  
 6 S.S.  
 (size) (material)

(6) pump 30 200  
 (HP) (yield gpm)  
 ELECTRIC  
 (type power)

(7) electric log YES  
 (yes or no)  
 STATE  
 (organization running log)

(8) how well bottom plugged BACK-WASH VALVE

DRILLERS REMARKS:


CODED

RECEIVED  
 JAN 21 1986

Department of Natural Resources  
 Bureau of Land & Water Resources

If well telescopes please sketch and show depths.

GROUND LEVEL

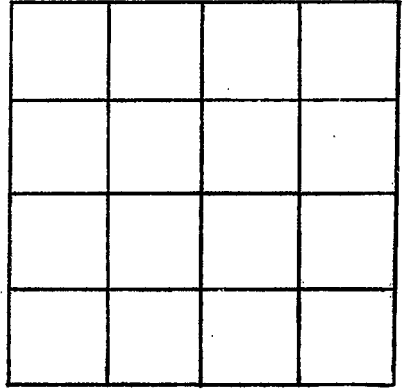

SECTION 12

Please indicate well location X.

ADDITIONAL INFORMATION

If more than one screen,  
show locations of each on sketch.