

Tippah
H 2000
3-16-77

MISSISSIPPI
BOARD OF WATER COMMISSIONERS
416 North State Street
15F Jackson, Mississippi 39201

WATER WELL DRILLERS LOG

MAR 16 1977
date well completed

15F Billy R. Simpson
firm name

TIPPAAH
county well located

LANDOWNER:
RANDY GRISHAM
Ripley Miss
(mailing address)
WELL LOCATION:
sec 10 T 4 N R 2 E S
6 miles W of Ripley
(distance) (direction) (nearest town)

description of fomations encountered	from	to
SURFACE CLAY	0	12
SAND	12	36
ROCK	36	37
Blue CLAY	37	233
FINE SAND + CLAY	233	246
LIMESTONE + SAND	246	305
Blue CLAY	305	320
LIMESTONE + SAND	320	336

WELL PURPOSE: HOME
(home, irrigation, municipal, industrial)


WELL COMPLETION DATA:
(1) diameter (inches) 4
(2) total depth (feet) 336
(3) static water level (feet) 56 below top of ground.
(4) casing PVC, 110 (material), (depth)
(size) if telescope see back.
(5) screen None 0 (length), (depth to top)
(size) (material)
(6) pump 1/2 10 (HP) (yield gpm)
Elec (type power)
(7) electric log NO (yes or no)
(organization running log)
(8) how well bottom plugged None

RECEIVED
MAY 31 1977
MISS. BD. OF WATER COMM.

DRILLERS REMARKS:

If well telescopes please sketch and show depths.

GROUND LEVEL

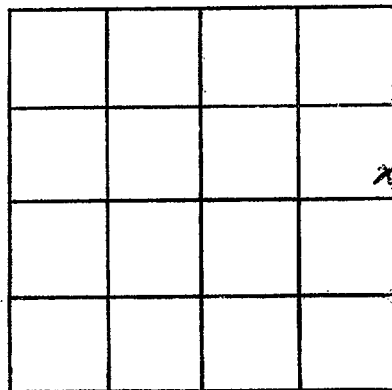

SECTION 10

Please indicate well location X.

ADDITIONAL INFORMATION

If more than one screen,
show locations of each on sketch.