

Tippah
 H 2000
 3-31-77

MISSISSIPPI
 BOARD OF WATER COMMISSIONERS
 416 North State Street
 Jackson, Mississippi 39201

WATER WELL DRILLERS LOG

MAR 31 1977
 date well completed

Billy R. J. Jansen
 firm name

TIPPAAH
 county well located

LANDOWNER:
 Guyton Newmally
 Ripley Miss
 (mailing address)

WELL LOCATION:
 sec. 13 T. 4 N. R. 2 E
 S
 5 miles W of Ripley
 (distance) (direction) (nearest town)

WELL PURPOSE: Home
 (home, irrigation, municipal, industrial)

- WELL COMPLETION DATA:
- (1) diameter (inches) 4
 - (2) total depth (feet) 277
 - (3) static water level (feet) 15 below top of ground
 - (4) casing PVC 58 (material) (depth)
 - (size) if telescope see back.
 - (5) screen None (length) (depth to top)
 - (size) (material)
 - (6) pump 1/2 10 (HP) (yield gpm)
 - Elec (type power)
 - (7) electric log No (yes or no)
 - (organization running log)
 - (8) how well bottom plugged

description of formations encountered	from	to
SURFACE CLAY	0	7
SOAPSTONE CLAY	7	18
SAND	18	38
Blue CLAY	38	107
ROCK & SAND	107	109
Blue CLAY	109	115
LIMESTONE & GREEN SAND	115	175
Blue CLAY	175	205
ROCK & CLAY	205	210
LIMESTONE & SAND	210	277


DRILLERS REMARKS:

RECEIVED
 MAY 31 1977

MISS. BD. OF WATER COMM.

If well telescopes please sketch and show depths.

GROUND LEVEL

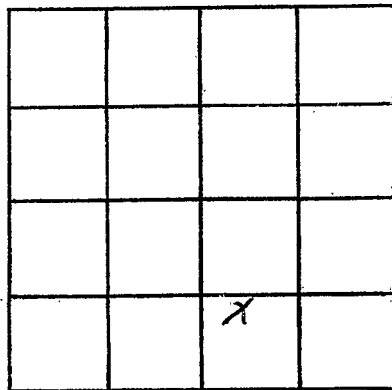

SECTION 13

Please indicate well location X.

ADDITIONAL INFORMATION

If more than one screen, show locations of each on sketch.