

TIPPAH

H 2002

4-6-78

MISSISSIPPI
 BOARD OF WATER COMMISSIONERS
 416 North State Street
 Jackson, Mississippi 39201

WATER WELL DRILLERS LOG

APR 6

19

78 Billy R Simpson


TIPPAH

date well completed

firm name

county well located

LANDOWNER:		description of formations encountered	from	to
Rooney Farrow				
Blue Mtn. Miss (mailing address)		Blue CLAY	31	213
		Limestone	213	248
		Blue CLAY	248	262
		Limestone	262	275
		Blue CLAY	275	305
		Limestone	305	313
		Blue CLAY	313	318
		Limestone + SAND	318	357
		Blue CLAY	357	379
		Limestone + Coarse Sand	379	400
WELL LOCATION:				
sec. 26 T 4 N R 2 E				
S 5 W				
3 miles NW of Blue Mtn				
(distance) (direction) (nearest town)				
WELL PURPOSE: Home				
(home, irrigation, municipal, industrial)				
WELL COMPLETION DATA:				
(1) diameter (inches) 4				
(2) total depth (feet) 400				
(3) static water level (feet) 36 below top of ground.				
(4) casing PVC 120 (material) (depth)				
(size) if telescope see back.				
(5) screen NONE (length) (depth to top)				
(size) (material)				
(6) pump 1 1/2 25 (HP) (yield gpm)				
(type power)				
(7) electric log (yes or no)				
(organization running log)				
(8) how well bottom plugged				
DRILLERS REMARKS:				

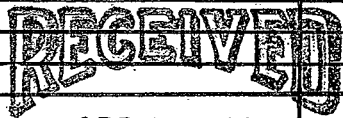


APR 24 1978

MISS. BD. OF WATER COMMISSIONERS

If well telescopes please sketch and show depths.

GROUND LEVEL

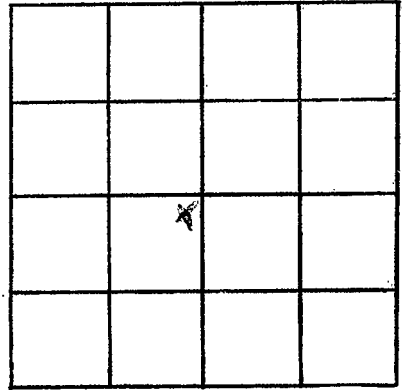

SECTION 26

Please indicate well location X.

ADDITIONAL INFORMATION

If more than one screen, show locations of each on sketch.