

Tippah  
#  
2003  
11-7-78

MISSISSIPPI  
BOARD OF WATER COMMISSIONERS  
416 North State Street  
Jackson, Mississippi 39201

WATER WELL DRILLERS LOG

No. 7 1978 Billy R Simpson Tippah  
date well completed firm name county well located

LANDOWNER:	description of formations encountered	from	to
CHARLENCE GODWIN Blue Mtn. Miss (mailing address)			
WELL LOCATION: sec. 35 T 4 R 2 E S 3 miles W of Blue Mtn (distance) (direction) (nearest town)	SAND	5	16
WELL PURPOSE: Home (home, irrigation, municipal, industrial)	SOAPSTONE CLAY	16	20
WELL COMPLETION DATA:	Blue CLAY	20	288
(1) diameter (inches) 4	LIMESTONE	288	325
(2) total depth (feet) 415	Blue CLAY	325	347
(3) static water level (feet) 131 below top of ground.	LIMESTONE & SAND	347	380
(4) casing PVC 200 (material) (depth)	Blue CLAY	380	393
(size) If telescope see back.	LIMESTONE	393	410
(5) screen NONE (length) (depth to top)	Blue CLAY	410	415
(size) (material)			
(6) pump 1/2 10 (HP) (yield gpm)			
Elec (type power)			
(7) electric log No (yes or no)			
(organization running log)			
(8) how well bottom plugged NONE			
DRILLERS REMARKS:			


Miss. Board of Water Comm.

APR 2 - 1979

RECEIVED

If well telescopes please sketch and show depths.

GROUND LEVEL

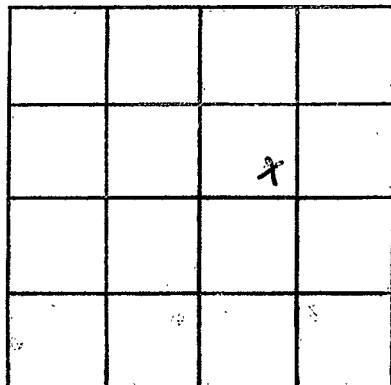

SECTION 35

Please indicate well location X.

ADDITIONAL INFORMATION

If more than one screen, show locations of each on sketch.