

Tippah
H 2004

MISSISSIPPI
BOARD OF WATER COMMISSIONERS
416 North State Street
Jackson, Mississippi 39201

8-28-80
AUG 28

WATER WELL DRILLERS LOG

19 29 Billy R. Simpson TIPPAAH
date well completed firm name county well located

LANDOWNER:
WYATT CANNADY
MEMPHIS TENN
(mailing address)

description of formations encountered	from	to
SILTSTONE CLAY	0	10
SANDSTONE CLAY	10	26
Blue CLAY	26	214
Rock + SAND	214	217
Blue CLAY	217	220
SAND + Limestone	220	273
Blue CLAY	273	306
Rock + CLAY	306	311
Limestone + SAND	311	355

WELL LOCATION:
sec. 1 T 4 R 2 E
6 S W of Ripley
(distance) (direction) (nearest town)

WELL PURPOSE: Home
(home, irrigation, municipal, industrial)

- WELL COMPLETION DATA:
- (1) diameter (inches) 4
 - (2) total depth (feet) 355
 - (3) static water level (feet) 80 below top of ground.
 - (4) casing PVC 136 (material) (depth)
 - (size) If telescope see back.
 - (5) screen NONE (length) (depth to top)
 - (size) 1/2 (material) 10 (HP) (yield gpm)
 - (6) pump (type power) ELEC
 - (7) electric log NO (yes or no)
 - (organization running log)
 - (8) how well bottom plugged NONE

DEPT. OF NATURAL RESOURCES
BUREAU OF LAND & WATER RESOURCES


APR 21 1980

RECEIVED

DRILLERS REMARKS:

If well telescopes please sketch and show depths.

GROUND LEVEL

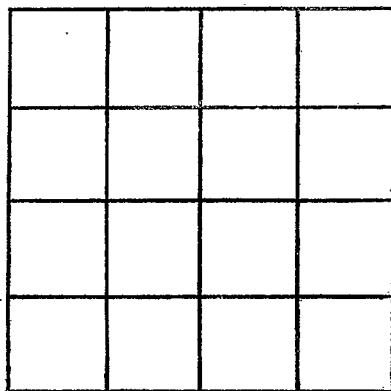

SECTION _____

Please indicate well location X.

ADDITIONAL INFORMATION

If more than one screen, show locations of each on sketch.