

Tippah
 H 2005
 12-4-79
 DEC 4 1979

MISSISSIPPI
 BOARD OF WATER COMMISSIONERS
 416 North State Street
 Jackson, Mississippi 39201

WATER WELL DRILLERS LOG

1979 Bill R. SIMMONS TIPPAAH
 date well completed firm name county well located

LANDOWNER:
 ROBT MEADOWS
 Ripley MS
 (mailing address)

description of formations encountered	from	to
SURFACE CLAY	0	4
SOAPSTONE CLAY	4	18
SAND & CLAY	18	58
Blue CLAY	58	236
SAND & LIMESTONE	236	285
Blue CLAY	285	313
LIMESTONE & SANDS	313	338

WELL LOCATION:
 sec. 35 T 4 N R 2 E
 S W of Ripley
 7 miles (distance) (direction) (nearest town)

WELL PURPOSE: HOME
 (home, irrigation, municipal, industrial)

WELL COMPLETION DATA:

(1) diameter (inches) 4

(2) total depth (feet) 338

(3) static water level (feet) 40 below top of ground

(4) casing PVC 12" (material) (depth)

(size) if telescope see back.

(5) screen NONE (length) (depth to top)

(size) (material)

(6) pump 1/2 10 (HP) (yield gpm)

Elec. (type power)

(7) electric log NO (yes or no)

(organization running log)

(8) how well bottom plugged NO

DEPT. OF NATURAL RESOURCES
 BUREAU OF LAND & WATER RESOURCES


APR 21 1980

RECEIVED

DRILLERS REMARKS:

If well telescopes please sketch and show depths.

GROUND LEVEL

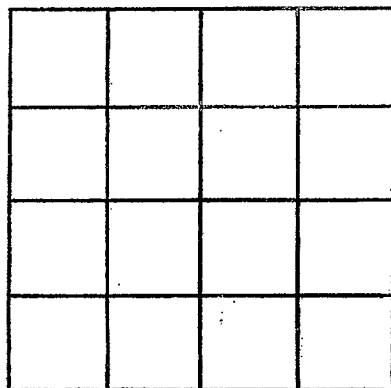

SECTION _____

Please indicate well location X.

ADDITIONAL INFORMATION

If more than one screen,
show locations of each on sketch.