

Tippah
H 2000
10-20-80

MISSISSIPPI
BOARD OF WATER COMMISSIONERS
416 North State Street
Jackson, Mississippi 39201

WATER WELL DRILLERS LOG

OCT 20 19 80 Bolly R Simpson TIPPANH
date well completed firm name county well located


LANDOWNER:	description of formations encountered	from	to
JAKE REED RIPLEY MISS (mailing address)			
WELL LOCATION: sec. <u>1</u> T. <u>4</u> R. <u>2</u> <u>7</u> miles <u>W</u> of <u>RIPLEY</u> (distance) (direction) (nearest town)	WHITE CLAY + SAND	4	52
WELL PURPOSE: <u>HOME</u> (home, irrigation, municipal, industrial)	Blue CLAY	52	145
WELL COMPLETION DATA:	Rock	145	146
(1) diameter (inches) <u>4</u>	Blue CLAY	146	272
(2) total depth (feet) <u>410</u>	CLAY + SAND	272	282
(3) static water level (feet) <u>132</u> below top of ground.	LIMESTONE + SAND	282	326
(4) casing <u>PVC</u> <u>160</u> (material) (depth)	Blue CLAY	326	362
<u>4</u> (size) If telescope see back.	LIMESTONE + SAND	362	410
(5) screen <u>NONE</u> (length) (depth to top)			
(size) (material)			
(6) pump <u>7/8</u> <u>10</u> (HP) (yield gpm)			
<u>Elec</u> (type power)			
(7) electric log <u>NO</u> (yes or no)			
(organization running log)			
(8) how well bottom plugged <u>NONE</u>			
DRILLERS REMARKS:			

DEPT. OF NATURAL RESOURCES
BUREAU OF LAND & WATER RESOURCES

APR 20 1981
RECEIVED

If well telescopes please sketch and show depths.

GROUND LEVEL

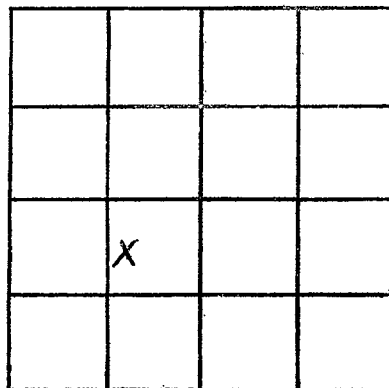

SECTION 1

Please indicate well location X.

ADDITIONAL INFORMATION

If more than one screen, show locations of each on sketch.