

MISSISSIPPI DEPARTMENT OF NATURAL RESOURCES

Bureau of Land and Water Resources

Southport Mall

P.O. Box 10631

Jackson, Mississippi 39209

WATER WELL DRILLERS LOG

Tippah
H2008
7-14-81

July 14 1981 Billy R. Simpson TIPPANH
 date well completed firm name county well located

LANDOWNER:
Tommy Burrows
Ripley Miss
 (mailing address)

description of formations encountered	from	to
<u>SURFACE CLAY</u>	<u>0</u>	<u>10</u>
<u>SAND & W. CLAY</u>	<u>10</u>	<u>65</u>
<u>Blue CLAY</u>	<u>65</u>	<u>151</u>
<u>ROCK</u>	<u>151</u>	<u>152</u>
<u>BLUE CLAY</u>	<u>152</u>	<u>283</u>
<u>LIME STONE & SAND</u>	<u>283</u>	<u>333</u>
<u>Blue CLAY</u>	<u>333</u>	<u>361</u>
<u>LIME STONE & SAND</u>	<u>333</u>	<u>412</u>

WELL LOCATION:
 sec. 1 T 4 S R 2 E
7 miles W of Ripley
 (distance) (direction) (nearest town)

WELL PURPOSE: HOME
 (home, irrigation, municipal, industrial)

- WELL COMPLETION DATA:
- (1) diameter (inches) 4
 - (2) total depth (feet) 412
 - (3) static water level (feet) 134 below top of ground.
 - (4) casing PVC, 166 (material), (depth)
 - (size) if telescope see back.
 - (5) screen NONE (length) (depth to top)
 - (size) (material)
 - (6) pump 3/4 10 (HP) (yield gpm)
 - EXCC (type power)
 - (7) electric log NO (yes or no)
 - (organization running log)
 - (8) how well bottom plugged NONE

DRILLERS REMARKS:


DEPT. OF NATURAL RESOURCES
 BUREAU OF LAND & WATER RESOURCES

JUL 22 1981

RECEIVED

If well telescopes please sketch and show depths.

GROUND LEVEL

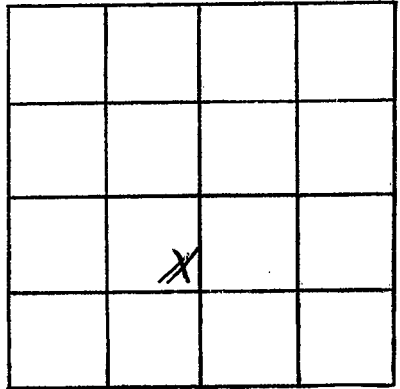

SECTION 1

Please indicate well location X.

ADDITIONAL INFORMATION

If more than one screen, show locations of each on sketch.