

MISSISSIPPI DEPARTMENT OF NATURAL RESOURCES

Bureau of Land and Water Resources

Southport Mall

P.O. Box 10631

Jackson, Mississippi 39209

WATER WELL DRILLERS LOG

Jippah  
H  
2011

6-14 1984  
 date well completed

Medlin  
 firm name

Jippah  
 county well located

LANDOWNER:  
Dale Bateman  
Ripley  
 (mailing address)

description of formations encountered	from	to
<u>Sapwood + Rock</u>	<u>0</u>	<u>80</u>
<u>Clay</u>	<u>80</u>	<u>180</u>
<u>Sand + Aquifer</u>	<u>180</u>	<u>200</u>

WELL LOCATION:  
 sec 27 T 4 R 2 E  
8 miles S.W of Ripley  
 (distance) (direction) (nearest town)

WELL PURPOSE:  
 (home, irrigation, municipal, industrial)

- WELL COMPLETION DATA:
- (1) diameter (inches) 4"
  - (2) total depth (feet) 220'
  - (3) static water level (feet) 80 below above top of ground.
  - (4) casing PVC, 220  
 (material) (depth)
  - \_\_\_\_\_ if telescope see back.  
 (size)
  - (5) screen 40' 110'  
 (length) (depth to top)
  - 4" PVC  
 (size) (material)
  - (6) pump 3/4 12  
 (HP) (yield gpm)
  - Electric  
 (type power)
  - (7) electric log \_\_\_\_\_  
 (yes or no)
  - \_\_\_\_\_ (organization running log)
  - (8) how well bottom plugged \_\_\_\_\_


DRILLERS REMARKS: \_\_\_\_\_

DEPT. OF NATURAL RESOURCES  
 BUREAU OF LAND & WATER RESOURCES

SEP 17 1984  
 RECEIVED

If well telescopes please sketch and show depths.

GROUND LEVEL

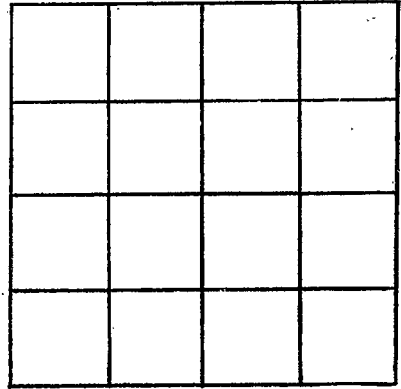

SECTION \_\_\_\_\_

Please indicate well location X.

ADDITIONAL INFORMATION

If more than one screen,  
show locations of each on sketch.