

TIPPAN  
H 2016  
10-15-73

MISSISSIPPI  
BOARD OF WATER COMMISSIONERS  
416 North State Street  
Jackson, Mississippi 39201

CODED

WATER WELL DRILLERS LOG

OCT 15 1973 Billy R. Simpson TIPPAN  
date well completed firm name county well located

LANDOWNER:  
MRS. WILLIE GRISHAM  
RIPLEY, MISS.  
(mailing address)

description of formations encountered	from	to
<u>SURFACE CLAY</u>	<u>0</u>	<u>12</u>
<u>SAND</u>	<u>12</u>	<u>18</u>
<u>YELLOW CLAY</u>	<u>18</u>	<u>30</u>
<u>BLUE CLAY</u>	<u>30</u>	<u>160</u>
<u>ROCK + SAND</u>	<u>160</u>	<u>218</u>
<u>SAND</u>	<u>218</u>	<u>238</u>
<u>ROCK</u>	<u>238</u>	<u>255</u>
<u>SAND</u>	<u>255</u>	<u>283</u>

WELL LOCATION:  
sec 4 T 4 R 2  
6 miles W of RIPLEY  
(distance) (direction) (nearest town)

WELL PURPOSE: HOME  
(home, irrigation, municipal, industrial)

- WELL COMPLETION DATA:
- (1) diameter (inches) 4
  - (2) total depth (feet) 283
  - (3) static water level (feet) 20 below top of ground.
  - (4) casing POC 60  
(material) (depth)  
if telescope see back.  
(size)
  - (5) screen NONE  
(length) (depth to top)  
(size) (material)
  - (6) pump 1/2 7  
(HP) (yield gpm)
  - ELECT.  
(type power)
  - (7) electric log No  
(yes or no)  
(organization running log)
  - (8) how well bottom plugged

CODED


UNIT 2/6

MISC. NO. OF

DRILLERS REMARKS:

If well telescopes please sketch and show depths.

GROUND LEVEL

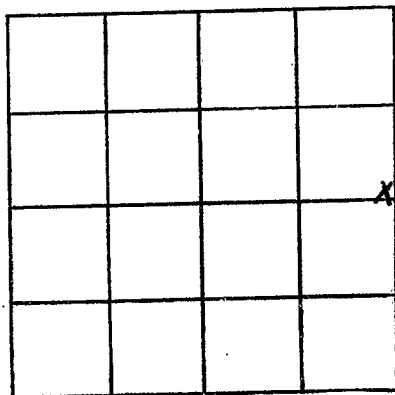

SECTION 4

Please indicate well location X.

ADDITIONAL INFORMATION

If more than one screen, show locations of each on sketch.