

Lippah  
J5  
7-20-68

MISSISSIPPI  
 BOARD OF WATER COMMISSIONERS  
 416 North State Street  
 Jackson, Mississippi 39201

CODED

WATER WELL DRILLERS LOG

7-20- 19 67 Jasper Well Co Lippah  
 date well completed firm name county well located

LANDOWNER: Burton Bryant  
 (mailing address)

description of formations encountered	from	to
<u>Mixed Clay</u>	<u>0</u>	<u>120</u>
<u>Soil + Rock</u>	<u>120</u>	<u>200</u>

WELL LOCATION:  
 sec. 10 T. 4 S. R. 3 E  
3 miles W of Ripley  
 (distance) (direction) (nearest town)

WELL PURPOSE: Home  
 (home, irrigation, municipal, industrial)

- WELL COMPLETION DATA:
- (1) diameter (inches) 4"
  - (2) total depth (feet) 200
  - (3) static water level (feet) 30 below above top of ground.
  - (4) casing PVC, 100,  
 (material) (depth)  
4" if telescope see back.  
 (size)
  - (5) screen 0 / 0  
 (length) (depth to top)  
0 / 0  
 (size) (material)
  - (6) pump 1/2 / 8  
 (HP) (yield gpm)  
Electric  
 (type power)
  - (7) electric log 0  
 (yes or no)  
0  
 (organization running log)
  - (8) how well bottom plugged 0

CODED


DEC 10 1967

DRILLERS REMARKS:

MISS. Bd. OF  
 WATER COMMISSIONERS

If well telescopes please sketch and show depths.

GROUND LEVEL

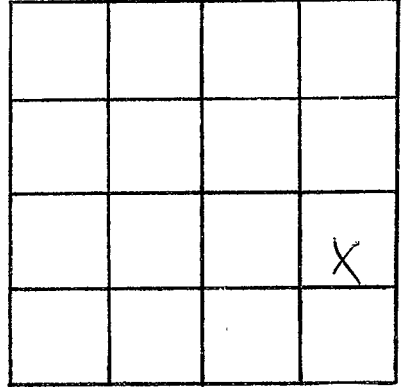

SECTION 10

Please indicate well location X.

ADDITIONAL INFORMATION

If more than one screen,  
show locations of each on sketch.