

Lippah
 517
 3-10-68

MISSISSIPPI
 BOARD OF WATER COMMISSIONERS
 416 North State Street
 Jackson, Mississippi 39201

CODED

WATER WELL DRILLERS LOG

3-10-1968 date well completed
 Jumper Well Co. firm name
 Lippah county well located

LANDOWNER:

Milt Welch
 Ripley Miss.
 (mailing address)

description of formations encountered

from to

Rock + Clay	0	150
Soil + Rock	150	240

WELL LOCATION:

sec 22 T 4 N R 3 E
 S
 2 miles S.W. of Ripley
 (distance) (direction) (nearest town)

WELL PURPOSE:

Home
 (home, irrigation, municipal, industrial)

WELL COMPLETION DATA:

- (1) diameter (inches) 4
- (2) total depth (feet) 240
- (3) static water level (feet) 60 below top of ground.
- (4) casing PVC, 100 (material), (depth)
 (size) if telescope see back.
- (5) screen 0, 0 (length), (depth to top)
 0, 0 (size), (material)
- (6) pump 0 (HP), 0 (yield gpm)
 0 (type power)
- (7) electric log 0 (yes or no)
 0 (organization running log)
- (8) how well bottom plugged 0

CODED


DRILLERS REMARKS:

DEC 10 1968

MISS. Bd. of WATER COMMISSIONERS

If well telescopes please sketch and show depths.

GROUND LEVEL

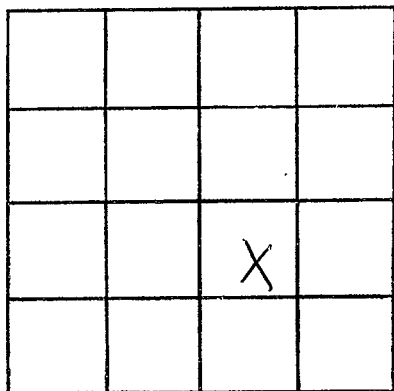

SECTION 22

Please indicate well location X.

ADDITIONAL INFORMATION

If more than one screen,
show locations of each on sketch.