

COPIED

MISSISSIPPI BOARD OF WATER COMMISSIONERS
416 North State Street
Jackson, Mississippi 39201

WATER WELL DRILLERS LOG

TIPPAH
121
1-3-69

1-3-69
date well completed

Jumper Well Co -
firm name

Tippah
Tippah
county well located

LANDOWNER:

West Higgins Dale & Paper
Ripley, Miss. 38663
(mailing address)

description of formations encountered

from to

Mixed Clay 0 60
Clay 60 120
Rock + Sand 120 200

WELL LOCATION:

26 T 4 S R 3 E
3 miles So. of Ripley
(distance) (direction) (nearest town)

WELL PURPOSE: industrial
(home, irrigation, municipal, industrial)

WELL COMPLETION DATA:

- (1) diameter (inches) 4"
- (2) total depth (feet) 200
- (3) static water level (feet) 50 below top of ground.
- (4) casing PVC, 100, (material), (depth), 4" (size) if telescope see back.
- (5) screen 0 (length), 0 (depth to top), 0 (size), 0 (material)
- (6) pump 1/2 (HP), 10 (yield gpm), Elec (type power)
- (7) electric log 0 (yes or no)
- (organization running log)

(8) how well bottom plugged 0


DRILLERS REMARKS:

FEB 18 1970

MISS. BD. OF WATER COMM.

If well telescopes please sketch and show depths.

GROUND LEVEL

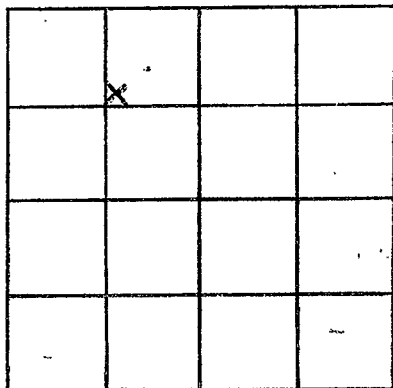

SECTION 26

Please indicate well location X.

ADDITIONAL INFORMATION

If more than one screen, show locations of each on sketch.