

TIPPAH  
 J 25  
 5-14-71

MISSISSIPPI  
 BOARD OF WATER COMMISSIONERS  
 416 North State Street  
 Jackson, Mississippi 39201

**CODED**

WATER WELL DRILLERS LOG

May-14-1971 J J Medler Tippah  
 date well completed firm name county well located

LANDOWNER: William Branch  
 Ripley, Miss

(mailing address)

WELL LOCATION:

sec. 2 T 4 N R 3 E  
 S W

\_\_\_\_\_ miles \_\_\_\_\_ of \_\_\_\_\_  
 (distance) (direction) (nearest town)

WELL PURPOSE:

(home, irrigation, municipal, industrial)

WELL COMPLETION DATA:

- (1) diameter (inches) 4
- (2) total depth (feet) 300
- (3) static water level (feet) 160 <sup>below</sup> above top of ground.

(4) casing PL 300'  
 (material) (depth)

\_\_\_\_\_ if telescope see back.  
 (size)

(5) screen 20' 280  
 (length) (depth to top)

4" PL  
 (size) (material)

(6) pump 3/4 7  
 (HP) (yield gpm)

(type power)

(7) electric log \_\_\_\_\_  
 (yes or no)

(organization running log)

(8) how well bottom plugged \_\_\_\_\_

description of formations encountered

from to


Red Clay	0	8
yellow "	8	19
Blue "	19	145
Rock	145	170
Blue Clay	170	185
Rock	185	300

**CODED**

DRILLERS REMARKS:

If well telescopes please sketch and show depths.

GROUND LEVEL

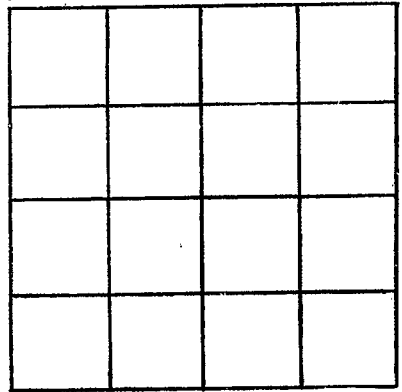

SECTION \_\_\_\_\_

Please indicate well location X.

ADDITIONAL INFORMATION

If more than one screen, show locations of each on sketch.