

TIPPAH

J 26

9-7-70

MISSISSIPPI BOARD OF WATER COMMISSIONERS 416 North State Street Jackson, Mississippi 39201

CODED

WATER WELL DRILLERS LOG

9-7 19 70 date well completed

JT Medlin firm name

Tippah county well located

LANDOWNER: Mattie Lou Cole

Ripley Amoco R# (mailing address)

Description of formations encountered

Table with 3 columns: Description of formations encountered, from, to. Rows include Clay, Blue clay, Rock, Sand, Blue clay, Rock, Blue cc, Sand, Blue Rock, Sand.

WELL LOCATION:

sec. 16 T 4 N R 3 E 5 miles (distance) S W of Ripley (nearest town)

WELL PURPOSE: (home, irrigation, municipal, industrial)

WELL COMPLETION DATA:

- (1) diameter (inches) 4
(2) total depth (feet) 330
(3) static water level (feet) 100 below top of ground.
(4) casing P 140 (material) (depth)
(5) screen 50 8 10 (length) (depth to top)
(6) pump 1 1/2 6 (HP) (yield gpm)
(7) electric log (yes or no)
(8) how well bottom plugged

CODED


OCT 7 1970

MISS. BD. OF WATER COM.

DRILLERS REMARKS:

If well telescopes please sketch and show depths.

GROUND LEVEL

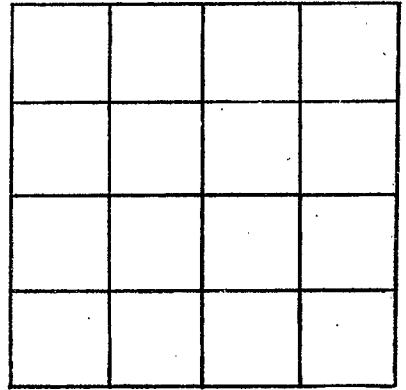

SECTION \_\_\_\_\_

Please indicate well location X.

ADDITIONAL INFORMATION

If more than one screen,  
show locations of each on sketch.