

MISSISSIPPI  
BOARD OF WATER COMMISSIONERS  
416 North State Street  
Jackson, Mississippi 39201

**CODED**

WATER WELL DRILLERS LOG

TIPPAH  
J27  
10-27-70

date well completed Oct 27 1970 firm name J. W. Webb & Sons county well located Tippha

LANDOWNER: Davis Lumber Co  
Ripley Miss  
(mailing address)  
WELL LOCATION:  
sec. 36 T 45 N R 3 E  
3 miles South of Ripley  
(distance) (direction) (nearest town)

description of formations encountered	from	to
<u>soil</u>	<u>0</u>	<u>11</u>
<u>Sand &amp; Rocks</u>	<u>11</u>	<u>54</u>
<u>Blue Rock</u>	<u>54</u>	<u>128</u>
<u>Water sand Rocks</u>	<u>128</u>	<u>225</u>

WELL PURPOSE:  
(home, irrigation, municipal, industrial)

WELL COMPLETION DATA:  
(1) diameter (inches) 5"  
(2) total depth (feet) 225'  
(3) static water level (feet) 77 below above top of ground.  
(4) casing Steel 57'  
(material) (depth)  
5" if telescope see back.  
(size)  
(5) screen 0 0  
(length) (depth to top)  
0 0  
(size) (material)  
(6) pump 1/2 Hk Sub 8  
(HP) (yield gpm)  
Elec  
(type power)  
(7) electric log 0  
(yes or no)  
0  
(organization running log)  
(8) how well bottom plugged Open


**CODED**

DRILLERS REMARKS:

NOV 18 1970

If well telescopes please sketch and show depths.

GROUND LEVEL

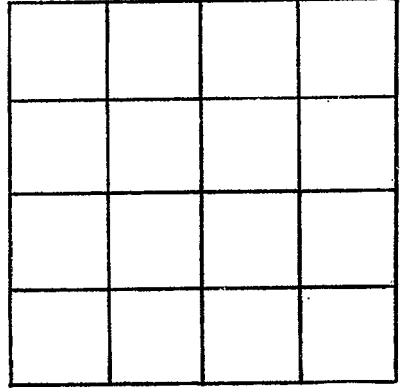

SECTION \_\_\_\_\_

Please indicate well location X.

ADDITIONAL INFORMATION

If more than one screen, show locations of each on sketch.