

Tippah  
 529  
 6-67

MISSISSIPPI  
 BOARD OF WATER COMMISSIONERS  
 416 North State Street  
 Jackson, Mississippi 39201

CODED  
 CODED

WATER WELL DRILLERS LOG

6-30 1967 Juniper Well Co. Tippah  
 date well completed firm name county well located

LANDOWNER:  
Aster Womack  
Ripley, Miss.  
 (mailing address)

description of formations encountered	from	to
<u>mixed clay</u>	<u>0</u>	<u>120</u>
<u>Sand + rock</u>	<u>120</u>	<u>180</u>

WELL LOCATION:  
362 T 4 R 3 E  
3 miles 50. of Ripley  
 (distance) (direction) (nearest town)

CODED

WELL PURPOSE: home  
 (home, irrigation, municipal, industrial)

- WELL COMPLETION DATA:
- (1) diameter (inches) 4"
  - (2) total depth (feet) 180
  - (3) static water level (feet) 50 below top of ground.
  - (4) casing PVC, 70 (material), (depth),  
4" if telescope see back.  
 (size)
  - (5) screen 0 (length), 0 (depth to top)  
0 (size), 0 (material)
  - (6) pump 3/4 (HP), 7 (yield gpm)  
Elect (type power)
  - (7) electric log No (yes or no)  
0  
 (organization running log)
  - (8) how well bottom plugged 0


DRILLERS REMARKS:

DEC 10 1967

MISS. BD. OF  
 WATER COMMISSIONERS

If well telescopes please sketch and show depths.

GROUND LEVEL

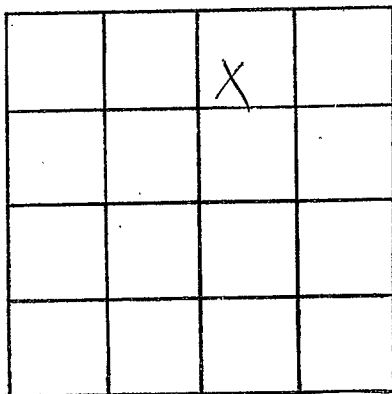

SECTION 2

Please indicate well location X.

ADDITIONAL INFORMATION

If more than one screen, show locations of each on sketch.