

TIPPAH  
 J-31  
 8-28-71

MISSISSIPPI  
 BOARD OF WATER COMMISSIONERS  
 416 North State Street  
 Jackson, Mississippi 39201

WATER WELL DRILLERS LOG

**CODED**

Aug 28 1971  
 date well completed

J. W. Webber  
 firm name

Tippanh  
 county well located

LANDOWNER: Collins Givelli  
 Ripley miss.  
 (mailing address)

description of formations encountered	from	to
Soil	0	1
Sand & Clay	1	144
Blue Rock	144	304
Water Rock	304	305
Water Sand & Rocks	305	402
Ripley Sand		

WELL LOCATION:  
 sec. 7 T 45 N R 3 E  
 5/4 miles north W of Ripley  
 (distance) (direction) (nearest town)

WELL PURPOSE:  
 (home, irrigation, municipal, industrial)

- WELL COMPLETION DATA:
- diameter (inches) 4"
  - total depth (feet) 402
  - static water level (feet) 21 below above top of ground.
  - casing Steel, 147 (material), (depth)  
 4" (size) If telescope see back.
  - screen 0 (length), 0 (depth to top)  
 (size) (material)
  - pump 1/2 HP, 8 (HP) (yield gpm)  
 Elec (type power)
  - electric log (yes or no)  
 (organization running log)
  - how well bottom plugged

**CODED**


SFP 16 1971

MISS. BD. OF  
 WATER COMM.

DRILLERS REMARKS:

If well telescopes please sketch and show depths.

GROUND LEVEL

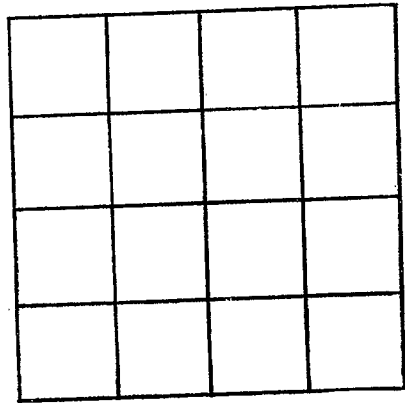

SECTION \_\_\_\_\_

Please indicate well location X.

ADDITIONAL INFORMATION

If more than one screen,  
show locations of each on sketch.