

TIPPAH

J 33
3-19-62

WATER WELL DRILLERS LOG

Date: 3-19, 1962, Driller: J. G. [unclear] County: Tippah
(Name)

(1) Owner of Land: James B. [unclear]
(Name)
Ripley RFD 2
(Address)

(2) Location: 1/4, S 1/4, Sec. 26, T4, R3E
1 1/2 miles South, of Ripley
(distance) (direction) (Nearest Town)

(3) Topography: (Hilly) (Flat) (Level)

(4) Purpose of Well: _____
(Domestic Irrigation
Municipal, Industrial, Other)

Description & Color of Materials Sand, Clay, Red Clay, Shell, etc.	Thick- ness Feet	Depth Feet
<u>red clay</u>	<u>14</u>	<u>14</u>
<u>sand</u>	<u>15</u>	<u>30</u>
<u>Blue sand</u>	<u>10</u>	<u>110</u>
<u>rock & sand</u>	<u>20</u>	<u>130</u>
<u>rock</u>	<u>20</u>	<u>150</u>
<u>rock & sand</u>	<u>30</u>	<u>180</u>
<u>sand</u>	<u>35</u>	<u>230</u>

Information upon completion of well:

(1) Diameter 4 inches.

(2) Total Depth 230 feet.

(3) Water Level 32 feet below top of ground.

(4) Cased to 63, Size _____.


(5) Screen: Size _____, Length _____.

(6) Were any formations sealed against pollution?
_____ yes, _____ no.

If YES depth of formation _____

Why _____

Drillers Remarks: _____

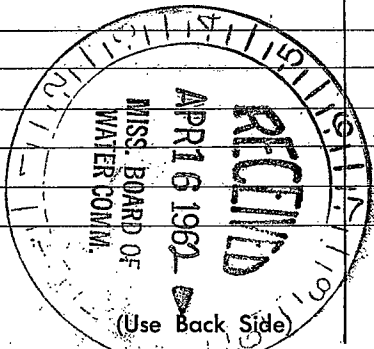

Well No. _____

