

TIPPAH
J 35
3-7-72

MISSISSIPPI
BOARD OF WATER COMMISSIONERS
416 North State Street
Jackson, Mississippi 39201

600 00
30 00
30 00

CODED

WATER WELL DRILLERS LOG

37 1972 date well completed J.T. Madlin firm name Tippah county well located

LANDOWNER: A.C. Prother
Ripley H.W. 2 E.
(mailing address)

| description of formations encountered | from | to |
|---------------------------------------|------|-----|
| red clay | 0 | 17 |
| rock | 17 | 56 |
| Blue " | 56 | 118 |
| rock & sand | 118 | 170 |

WELL LOCATION:
sec. 5 T 4 N R 3 E
4 miles NE of Ripley
(distance) (direction) (nearest town)

WELL PURPOSE:
(home, irrigation, municipal, industrial)

- WELL COMPLETION DATA:
- (1) diameter (inches) 4
 - (2) total depth (feet) 170
 - (3) static water level (feet) 80 below above top of ground.
 - (4) casing P 170
(material) (depth)
(size) if telescope see back.
 - (5) screen 10 160
(length) (depth to top)
4 P
(size) (material)
 - (6) pump 1/2 6
(HP) (yield gpm)
E
(type power)
 - (7) electric log (yes or no) _____
(organization running log) _____
 - (8) how well bottom plugged COP

CODED


APR 11 1972

MISS. HD. 05
WATER COM.

DRILLERS REMARKS:

If well telescopes please sketch and show depths.

GROUND LEVEL

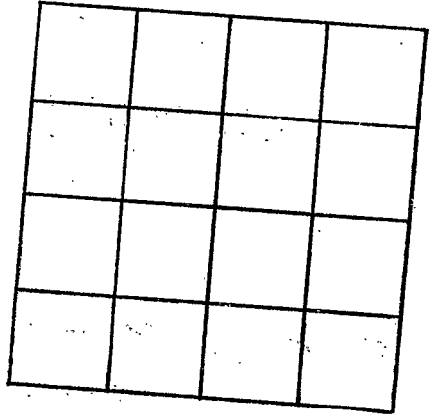

SECTION _____

Please indicate well location X.

ADDITIONAL INFORMATION

A series of horizontal lines for recording additional information.

If more than one screen, show locations of each on sketch.