

TIPPAH  
J 40  
6-25-72

MISSISSIPPI  
BOARD OF WATER COMMISSIONERS  
416 North State Street  
Jackson, Mississippi 39201

63600  
3380

WATER WELL DRILLERS LOG

# 20980

6-25-19 ~~72~~ Medlin Tippah  
date well completed firm name county/well located


LANDOWNER	description of formations encountered	from	to
Ray Bartley Ripley	Clay	0	23
	Rock	23	20
	Blue Clay	20	120
	rock & sand	120	160
(mailing address)			
WELL LOCATION:			
sec. 2 T 7 N R 3 E S W			
2 miles NE of Ripley (distance) (direction) (nearest town)			
WELL PURPOSE: (home, irrigation, municipal, industrial)			
WELL COMPLETION DATA:			
(1) diameter (inches) 4			
(2) total depth (feet) 160			
(3) static water level (feet) 90 below top of ground.			
(4) casing P 25 (material) (depth)			
_____ if telescope see back. (size)			
(5) screen _____ (length) (depth to top)			
_____ (size) _____ (material)			
(6) pump 1/2 5 (HP) (yield gpm)			
_____ (type power)			
(7) electric log _____ (yes or no)			
_____ (organization running log)			
(8) how well bottom plugged _____			
DRILLERS REMARKS: _____			

JUL 18 1972

Assoc. of  
Water Comm.

If well telescopes please sketch and show depths.

GROUND LEVEL

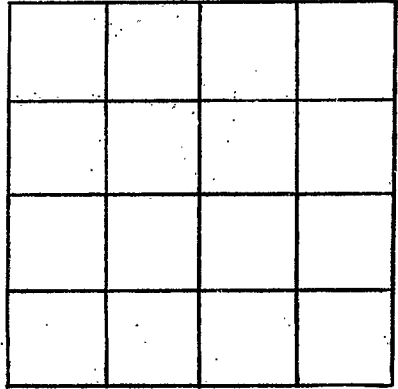

SECTION \_\_\_\_\_

Please indicate well location X.

ADDITIONAL INFORMATION

A series of horizontal lines for recording additional information, starting below the 'ADDITIONAL INFORMATION' header and extending to the bottom of the page.

If more than one screen, show locations of each on sketch.