

TIPPAH
J41
8-19-72

MISSISSIPPI
BOARD OF WATER COMMISSIONERS
416 North State Street
Jackson, Mississippi 39201

WATER WELL DRILLERS LOG

CODED

8-19
date well completed

1972 J.T. Medlin
firm name

Tippah
county well located


LANDOWNER: <u>David Hutchins</u> <u>Rt # 2</u>	description of formations encountered	from	to
<u>Ripley</u> (mailing address)	<u>Red CLAY</u> <u>Blue CLAY</u> <u>SAND & Rock</u>	<u>0</u> <u>20</u> <u>130</u>	<u>20</u> <u>130</u> <u>185</u>
WELL LOCATION: sec. <u>24</u> T <u>4</u> N R <u>3</u> E <u>5</u> miles <u>SE</u> of <u>Ripley</u> (distance) (direction) (nearest town)			
WELL PURPOSE: <u>HOME</u> (home, irrigation, municipal, industrial)			
WELL COMPLETION DATA:			
(1) diameter (inches) <u>4</u>			
(2) total depth (feet) <u>185</u>			
(3) static water level (feet) <u>70</u> ^(below) _{above} top of ground.			
(4) casing <u>Plastic</u> <u>60</u> (material) (depth)			
_____ if telescope see back. (size)			
(5) screen <u>Ø</u> _____ (length) (depth to top)			
_____ (size) _____ (material)			
(6) pump <u>1</u> <u>6</u> (HP) (yield gpm) <u>Electric</u> (type power)			
(7) electric log _____ (yes or no)			
_____ (organization running log)			
(8) how well bottom plugged _____			
DRILLERS REMARKS: _____			

CODED

081 12 1972

If well telescopes please sketch and show depths.

GROUND LEVEL

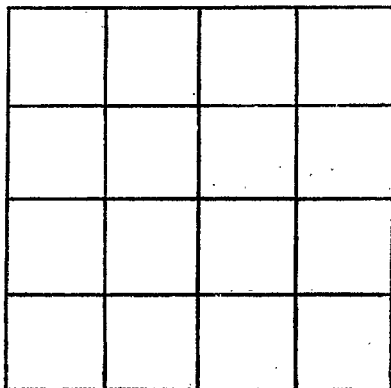

SECTION _____

Please indicate well location X.

ADDITIONAL INFORMATION

If more than one screen,
show locations of each on sketch.