

TIPPAH
J42
8-21-72

MISSISSIPPI
BOARD OF WATER COMMISSIONERS
416 North State Street
Jackson, Mississippi 39201

CODED

WATER WELL DRILLERS LOG

8-21-72 19 J. T. Madlin Tippah
date well completed firm name county well located

LANDOWNER: <u>Noel. A Kins</u> <u>R#2</u>	description of formations encountered	from	to
<u>Ripley</u> (mailing address)	<u>clay sand</u>	<u>0</u> <u>20</u>	<u>20</u> <u>125</u>
WELL LOCATION: sec. <u>19</u> T <u>4</u> N. R. <u>3</u> E <u>7</u> miles <u>SE</u> of <u>Ripley</u> (distance) (direction) (nearest town)			
WELL PURPOSE: <u>home</u> (home, irrigation, municipal, industrial)			
WELL COMPLETION DATA:			
(1) diameter (inches) <u>4</u>			
(2) total depth (feet) <u>125</u>			
(3) static water level (feet) <u>70</u> <u>below</u> top of ground.			
(4) casing <u>plastic</u> , <u>125</u> (material) (depth)			
_____ if telescope see back. (size)			
(5) screen <u>10</u> <u>115</u> (length) (depth to top)			
_____ <u>plastic</u> (size) (material)			
(6) pump <u>1/2</u> <u>8</u> (HP) (yield gpm)			
<u>Electric</u> (type power)			
(7) electric log _____ (yes or no)			
_____ (organization running log)			
(8) how well bottom plugged _____			
DRILLERS REMARKS: _____			


CODED

NOV 19 1972

MISSISSIPPI
BOARD OF WATER COMMISSIONERS

If well telescopes please sketch and show depths.

GROUND LEVEL

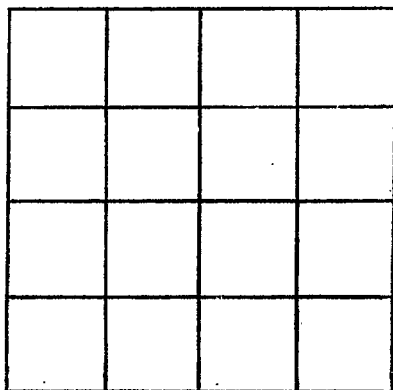

SECTION _____

Please indicate well location X.

ADDITIONAL INFORMATION

If more than one screen,
show locations of each on sketch.