

TIPPAH
J44
9-27-72

MISSISSIPPI
BOARD OF WATER COMMISSIONERS
416 North State Street
Jackson, Mississippi 39201

F.H.A.

\$ 600.00
30 00
~~630 00~~

WATER WELL DRILLERS LOG

9-27 19 72 date well completed
J.T. Medlin firm name
Tippek county well located

CODED

LANDOWNER:	description of formations encountered	from	to
Bauden Luskman, son Ruple W. A. W. 4. (mailing address)		Clay Sand blue clay Rock + Sand	0 19 27 167
WELL LOCATION:			
sec. 17 T N R 3 E 7 miles W of Ruple (distance) (direction) (nearest town)			
WELL PURPOSE: (home, irrigation, municipal, industrial)			
WELL COMPLETION DATA:			
(1) diameter (inches) 4			
(2) total depth (feet) 260			
(3) static water level (feet) 6 below top of ground.			
(4) casing (material) P (depth) 70			
(size) if telescope see back.			
(5) screen (length) (depth to top)			
(size) (material)			
(6) pump (HP) 1/2 (yield gpm) 6			
(type power) E			
(7) electric log (yes or no)			
(organization running log)			
(8) how well bottom plugged			
DRILLERS REMARKS:			


CODED

NOV 10 1972

J. OF
WATER BOARD.

If well telescopes please sketch and show depths.

GROUND LEVEL

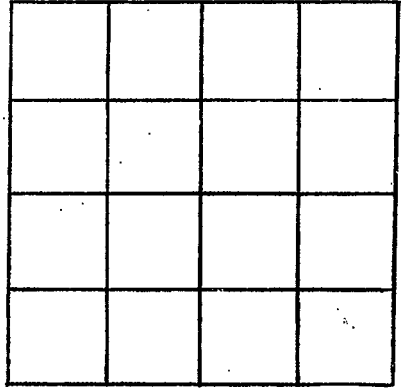

SECTION _____

Please indicate well location X.

ADDITIONAL INFORMATION

If more than one screen,
show locations of each on sketch.