

TIPPAH
J45
10-2-72

F.H.H. \$ 650.00
BOARD OF WATER COMMISSIONERS
416 North State Street
Jackson, Mississippi 39201
tel 3250
6825⁰⁰

WATER WELL DRILLERS LOG **CODED**

10 2 19 72 J.F. Modlin TIPPAH
date well completed firm name county well located

LANDOWNER: Joe Elliott
~~DANNY ESTON~~
Ripley MISSRI.
(mailing address)

description of formations encountered	from	to
Clay	0	27
blue "	27	111
rock & sand	111	270

WELL LOCATION:
sec. 16 T. 4 N. R. 30 E.
4 miles W of Ripley
(distance) (direction) (nearest town)

WELL PURPOSE:
(home, irrigation, municipal, industrial)

- WELL COMPLETION DATA:
- (1) diameter (inches) 4
 - (2) total depth (feet) 270
 - (3) static water level (feet) 60 below above top of ground.
 - (4) casing P 80
(material) (depth)
_____ if telescope see back.
(size)
 - (5) screen _____
(length) (depth to top)
_____ (size) _____ (material)
 - (6) pump 1 6
(HP) (yield gpm)
E
(type power)
 - (7) electric log _____
(yes or no)
_____ (organization running log)
 - (8) how well bottom plugged _____

CODED


DRILLERS REMARKS:

NOV 10 1972

MISS. HD. OF
WATER COMMISSIONERS

If well telescopes please sketch and show depths.

GROUND LEVEL

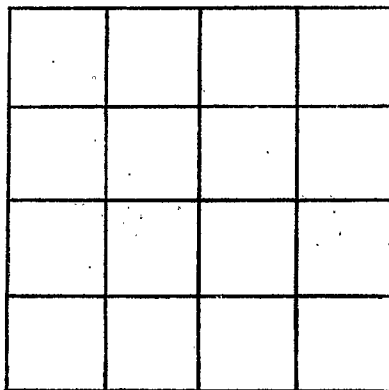

SECTION _____

Please indicate well location X.

ADDITIONAL INFORMATION

If more than one screen,
show locations of each on sketch.