

TIPPAH

J 47

6-2-71

MISSISSIPPI  
 BOARD OF WATER COMMISSIONERS  
 416 North State Street  
 Jackson, Mississippi 39201

WATER WELL DRILLERS LOG

6-7-71 19 date well completed

Juniper Well Drilling firm name


Tipah county well located

*Juniper Well Drilling Tipah*

LANDOWNER:		description of formations encountered	from	to
<i>James O. Butler</i>				
<i>Kipley Min</i> (mailing address)				
WELL LOCATION:		<i>Sand + Rock</i>	180	250
sec. <u>10</u> T. <u>4</u> N. R. <u>3</u> E. S. <u>3</u>				
3 miles W of <i>Kipley</i> (distance) (direction) (nearest town)				
WELL PURPOSE: <i>Home</i> (home, irrigation, municipal, industrial)				
WELL COMPLETION DATA:				
(1) diameter (inches) <u>4"</u>				
(2) total depth (feet) <u>253 ft</u>				
(3) static water level (feet) <u>70</u> below top of ground above				
(4) casing <u>PVC</u> <u>120</u> (material) (depth)				
<u>4"</u> (size) If telescope see back.				
(5) screen <u>0</u> <u>0</u> (length) (depth to top)				
<u>0</u> (size) (material)				
(6) pump <u>1/2</u> <u>3</u> (HP) (yield gpm)				
<u>Electric</u> (type power)				
(7) electric log <u>NO</u> (yes or no)				
<u>0</u> (organization running log)				
(8) how well bottom plugged <u>0</u>				
DRILLERS REMARKS:				
NOV 20 1972				
MISS. BD. OF WATER COMMISSIONERS				

If well telescopes please sketch and show depths.

GROUND LEVEL

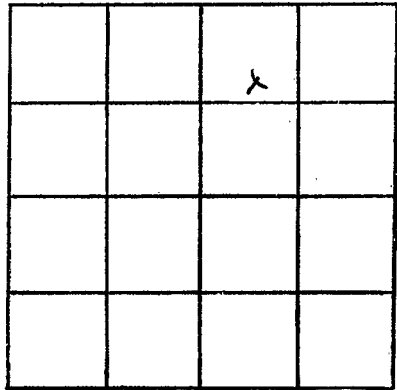

SECTION 10

Please indicate well location X.

ADDITIONAL INFORMATION

If more than one screen,  
show locations of each on sketch.